

PANOLA  
C 15  
9-28-72

MISSISSIPPI  
BOARD OF WATER COMMISSIONERS  
416 North State Street  
Jackson, Mississippi 39201

**CODED**

WATER WELL DRILLERS LOG

9-28 1972 James R. Lipe Panola  
date well completed firm name county well located

LANDOWNER: William Lewers  
221 S Como Miss  
(mailing address)

description of formations encountered	from	to
clay	0	20
"	20	40
sand	40	60
"	60	80
gravel	80	100
sand and gravel	100	120
sand	120	139

WELL LOCATION:  
sec 22 T 6 N R 7 E  
2 miles North of Como  
(distance) (direction) (nearest town)

WELL PURPOSE: Home  
(home, irrigation, municipal, industrial)

WELL COMPLETION DATA:

- (1) diameter (inches) 4"
- (2) total depth (feet) 139
- (3) static water level (feet) 80 below above top of ground.
- (4) casing PVC, 129,  
(material) (depth)  
4 if telescope see back.  
(size)
- (5) screen 10, 129  
(length) (depth to top)  
4, PVC  
(size) (material)
- (6) pump 3/4, 10  
(HP) (yield gpm)  
Elec.  
(type power)
- (7) electric log no  
(yes or no)  
no  
(organization running log)
- (8) how well bottom plugged PVC  
PIVA

**CODED**


057-2 1972

MISS. BD. OF  
WATER COMMISSIONERS

DRILLERS REMARKS:

If well telescopes please sketch and show depths.

GROUND LEVEL

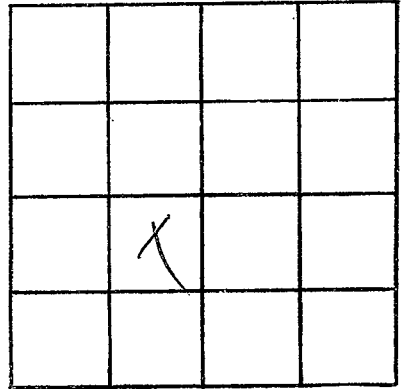

SECTION 92

Please indicate well location X.

ADDITIONAL INFORMATION

If more than one screen,  
show locations of each on sketch.