

**MISSISSIPPI  
BOARD OF WATER COMMISSIONERS**  
416 North State Street  
Jackson, Mississippi 39201

**WATER WELL DRILLERS LOG**

**CODED**

**PANOLA**  
**C16**  
**9-25-72**

9-25  
date well completed

1972 James R. Lipe  
firm name

county well located

**LANDOWNER:**  
Clarence Jennings  
Como Miss.  
(mailing address)

description of formations encountered	from	to
CLAY	0	20
SAND	20	40
SAND	40	80
CLAY	80	120
SAND and CLAY	120	140
SAND	140	160
"	160	184

**WELL LOCATION:**  
sec. 30 T 6 N R 7 E  
3 miles N.W. of Como  
(distance) (direction) (nearest town)

**WELL PURPOSE:** HOME  
(home, irrigation, municipal, industrial)

- WELL COMPLETION DATA:**
- (1) diameter (inches) 4
  - (2) total depth (feet) 184
  - (3) static water level (feet) 80 below/above top of ground.
  - (4) casing: PVC, 174,  
(material) (depth)  
4 if telescope see back.  
(size)
  - (5) screen: 10', 174  
(length) (depth to top)  
4, PVC  
(size) (material)
  - (6) pump: 3/4, 12  
(HP) (yield gpm)  
Elec.  
(type power)
  - (7) electric log NO  
(yes or no)  
NO  
(organization running log)
  - (8) how well bottom plugged PVC  
PLUG

**CODED**


OCT 9 1972

MISS. DIV. OF  
WATER RESOURCES

**DRILLERS REMARKS:**

If well telescopes please sketch and show depths.

GROUND LEVEL

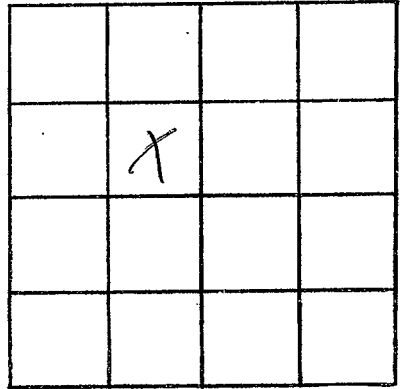

SECTION 30

Please indicate well location X.

ADDITIONAL INFORMATION

If more than one screen,  
show locations of each on sketch.