

PANOLA
C18
2-5-73

MISSISSIPPI
BOARD OF WATER COMMISSIONERS
416 North State Street
Jackson, Mississippi 39201

CODED

WATER WELL DRILLERS LOG

2-5 1973 Bob Hill Panola
date well completed firm name county well located

LANDOWNER:

Lester Lee Clark

description of formations encountered

clay sint

from

to

10

Como, miss
(mailing address)

red sand

10

20

WELL LOCATION:

sec. 19 T 6 N R 7 E
3 miles NW of Como
(distance) (direction) (nearest town)

yellow clay

20

40

red sand

40

60

gravel

60

110

WELL PURPOSE: Drinking
(home, irrigation, municipal, industrial)

white sand

110

140

WELL COMPLETION DATA:

(1) diameter (inches) 4
(2) total depth (feet) 140
(3) static water level (feet) 93 below above
top of ground.

(4) casing Plastic, 140
(material) (depth)

(size) If telescope see back.

(5) screen 20, 120
(length) (depth to top)

4, Plastic
(size) (material)

(6) pump 1/2, 10
(HP) (yield gpm)

E. Lee
(type power)

(7) electric log no
(yes or no)

(organization running log)

(8) how well bottom plugged plugged

DRILLERS REMARKS:


CODED

JUN 24 1974

MISS. BO. OF WATER COMMISSIONERS

If well telescopes please sketch and show depths.

GROUND LEVEL

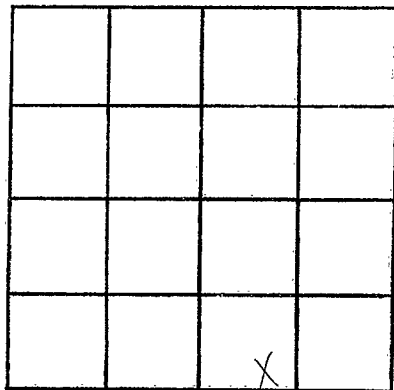

SECTION 19 :

Please indicate well location X.

ADDITIONAL INFORMATION

If more than one screen,
show locations of each on sketch.