

PANOLA  
 C-19  
 6-25-74

MISSISSIPPI  
 BOARD OF WATER COMMISSIONERS  
 416 North State Street  
 Jackson, Mississippi 39201

CODED

WATER WELL DRILLERS LOG

6-25-74 19 Bob Smith & Son ~~Fate~~ Panola  
 date well completed firm name county well located

LANDOWNER:	description of formations encountered	from	to
Earl Lee Bradford 419 Short Street Senatobia, Mississippi (mailing address)			
WELL LOCATION:	Red sand	10'	30'
sec. 30 T 6 N R 2 E 4 miles NW of Como (distance) (direction) (nearest town)	Clay & Sand	30'	90'
WELL PURPOSE: Home (home, irrigation, municipal, industrial)	Sand	90'	130'
WELL COMPLETION DATA:			
(1) diameter (inches) 4"			
(2) total depth (feet) 130'			
(3) static water level (feet) 60' below top of ground.			
(4) casing Plastic 130' (material) (depth)			
(size) if telescope see back.			
(5) screen 10' 120' (length) (depth to top)			
4" Plastic (size) (material)			
(6) pump 1/3 12 (HP) (yield gpm)			
Electric (type power)			
(7) electric log No (yes or no)			
(organization running log)			
(8) how well bottom plugged plugged			
DRILLERS REMARKS:			


CODED

RECEIVED  
 RECEIVED

JUN - 5 1974

If well telescopes please sketch and show depths.

GROUND LEVEL

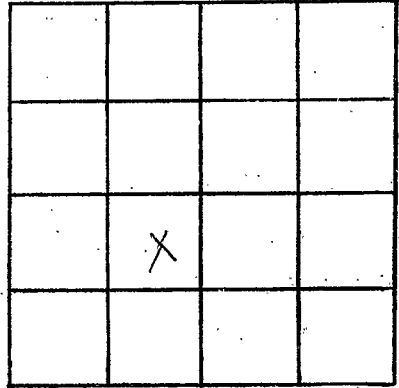

SECTION 20

Please indicate well location X.

ADDITIONAL INFORMATION

If more than one screen, show locations of each on sketch.