

Panola
 C20
 12-4-74

MISSISSIPPI
 BOARD OF WATER COMMISSIONERS
 416 North State Street
 Jackson, Mississippi 39201

CODED

WATER WELL DRILLERS LOG

12-4 date well completed
 1974 Life Well Co. firm name
 Panola county well located

LANDOWNER:
 Bill Wallace
 Como Miss.
 (mailing address)

description of formations encountered	from	to
Top soil	0	20
sand and gravel	20	40
gravel	40	60
il	60	80
sand and gravel	80	100
white sand	100	150

WELL LOCATION:
 sec. 20 T 6 N R 17 E
 2 miles north of Como
 (distance) (direction) (nearest town)

WELL PURPOSE:
 (home, irrigation, municipal, industrial)

CODED

WELL COMPLETION DATA:

- (1) diameter (inches) 4
- (2) total depth (feet) 150
- (3) static water level (feet) 90 below top of ground.
- (4) casing PVC 140 (material) (depth)
 4 (size) if telescope see back.
- (5) screen 10 140 (length) (depth to top)
 4 PVC (size) (material)
- (6) pump 3/4 10 (HP) (yield gpm)
 elec. (type power)
- (7) electric log no (yes or no)
 no (organization running log)
- (8) how well bottom plugged PVC cap

RECEIVED


DEC 31 1974

DRILLERS REMARKS:

MISS. RD. OF WATER COMM.

If well telescopes please sketch and show depths.

GROUND LEVEL

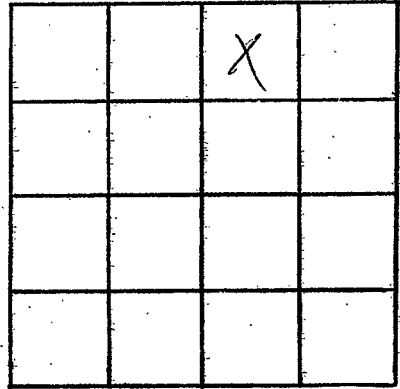

SECTION 20

Please indicate well location X.

ADDITIONAL INFORMATION

If more than one screen, show locations of each on sketch.