

Penola  
C 21  
5-5-75

MISSISSIPPI  
 BOARD OF WATER COMMISSIONERS  
 416 North State Street  
 Jackson, Mississippi 39201

CODED

WATER WELL DRILLERS LOG

May 5 ~~1975~~ 1975 North Miss Well Drilling Penola  
 date well completed firm name county well located

LANDOWNER: <u>David Huston Walker</u>	description of formations encountered	from	to
(mailing address)			
<u>Penola Miss</u>	<u>Clay &amp; sand</u>	<u>0</u>	<u>15</u>
	<u>Gravel</u>	<u>15</u>	<u>30</u>
	<u>Clay</u>	<u>30</u>	<u>90</u>
	<u>Sand</u>	<u>90</u>	<u>120</u>

WELL LOCATION:  
 sec. 30 T. 6 N. R. 7 E. <sup>15E</sup>  
2 miles W of Penola  
 (distance) (direction) (nearest town)

WELL PURPOSE: Home  
 (home, irrigation, municipal, industrial)

- WELL COMPLETION DATA:
- (1) diameter (inches) 4 1/4
  - (2) total depth (feet) 120
  - (3) static water level (feet) 90 below top of ground.
  - (4) casing Plastic, 120  
 (material) (depth)  
 (size) if telescope see back.
  - (5) screen 10' 110  
 (length) (depth to top)  
4 Plastic  
 (size) (material)
  - (6) pump 1/2 12  
 (HP) (yield gpm)  
Electric  
 (type power)
  - (7) electric log NO  
 (yes or no)  
 (organization running log)
  - (8) how well bottom plugged Plugged

CODED


MISSISSIPPI  
 BOARD OF WATER COMMISSIONERS  
 JUN 20 1975

MISS. BD. OF WATER COMM

DRILLERS REMARKS:

If well telescopes please sketch and show depths.

GROUND LEVEL

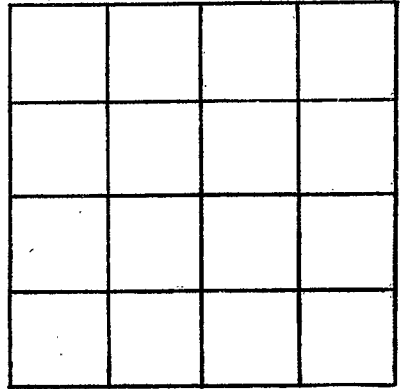

SECTION \_\_\_\_\_

Please indicate well location X.

ADDITIONAL INFORMATION

If more than one screen, show locations of each on sketch.