

Panola
C 22
6-6-75

MISSISSIPPI
 BOARD OF WATER COMMISSIONERS
 416 North State Street
 Jackson, Mississippi 39201

CODED

WATER WELL DRILLERS LOG

June 6 1975 North Miss Well Drilling Panola
 date well completed firm name county well located

LANDOWNER Loace Holt
Cano Miss
 (mailing address)
 WELL LOCATION:
 sec. 2 T. E N. R. 7 15E
1 3/4 miles W of Cano
 (distance) (direction) (nearest town)

WELL PURPOSE: Home
 (home, irrigation, municipal, industrial)

WELL COMPLETION DATA:
 (1) diameter (inches) 4"
 (2) total depth (feet) 120
 (3) static water level (feet) 93 below above top of ground.
 (4) casing Plastic 120
 (material) (depth)
 (size) if telescope see back.
 (5) screen 10' 110
 (length) (depth to top)
4 Plastic
 (size) (material)
 (6) pump 3/4 15
 (HP) (yield gpm)
Elec
 (type power)
 (7) electric log No
 (yes or no)
 (organization running log)
 (8) how well bottom plugged Plug

description of formations encountered	from	to
<u>Clay & Sand</u>	<u>0</u>	<u>21</u>
<u>Gravel</u>	<u>21</u>	<u>35</u>
<u>Clay</u>	<u>35</u>	<u>98</u>
<u>Sand</u>	<u>98</u>	<u>120</u>

CODED


RECEIVED
 JUN 20 1975

DRILLERS REMARKS:

MISS. BD. OF WATER COMMISSIONERS

If well telescopes please sketch and show depths.

GROUND LEVEL

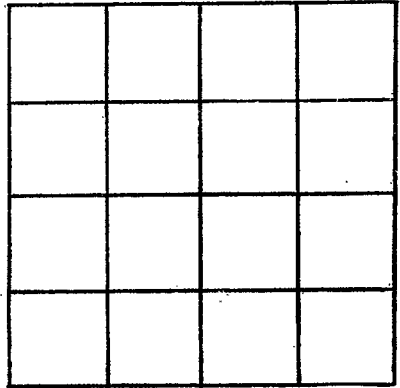

SECTION _____

Please indicate well location X.

ADDITIONAL INFORMATION

If more than one screen,
show locations of each on sketch.