

MISSISSIPPI DEPARTMENT OF ENVIRONMENTAL QUALITY
Office of Land and Water Resources

P. O. Box 10631
Jackson, MS 39289-0631
WATER WELL DRILLERS LOG

COUNTY WELL LOCATED DANOLA	
WELL NUMBER 216	CODED
C24	
DATE WELL COMPLETED	

PERMIT NUMBER
NAME OF DRILLING FIRM SMITH WELL DRILLING & SEW.

NAME & MAILING ADDRESS OF LANDOWNER JEFF FARMER (Chapel) 927 ABE CHARLE LP Como, MS			
WELL LOCATION:	SEC	TOWNSHIP	RANGE
	C20	T6	R27
DISTANCE	DIRECTION	NEAREST TOWN	
3 Miles	N	of Como	
OTHER LANDMARK			
WELL PURPOSE: Home, Irrigation, Municipal, Industrial, Fish Pond, etc. HOME			

PUMP DATA			
PUMP TYPE (Circle One): <input checked="" type="radio"/> Submersible, Turbine, Jet, Flowing Well, Other (Describe) _____			
POWER TYPE (Circle One): <input checked="" type="radio"/> Electric, Tractor, Diesel, Gasoline, Butane, Other (Describe) _____ H/P 3/4			
Pump Capacity (GPM)	No. of Stages	Setting Depth	
12	11	90 FT.	
PUMP TEST			
Well yielded 18 GPM with a drawdown of 4 ft. after 1 hours of pumping			

WELL DATA		
Well Depth 155	Casing Diameter (In.) 4"	Casing Length (Ft.) 135
Type of Casing PVC	Hole Depth 155	Depth to Static Water Level 63
TYPE OF COMPLETION: (Circle One or More): Gravel Packed, Underreamed, Telescoped, Natural Development, Open Hole, Other (Describe) WASHED SAND		
WELL GROUTED TO A DEPTH OF 10 FEET Type Grout (circle one) <input checked="" type="radio"/> Cement, Bentonite, or Mix		

LOG DATA	
TYPE OF LOG RUN (Circle One): No Log Run, Electric, Gamma Ray, Density, Sonic, Neutron, Other (Describe) _____	
Name of Organization Running Log	

SCREEN DATA		
Diameter - Inches 4"	Length - Feet 20	Slot Size - Inches 14/1005
Screen Type PVC	Depth to Bottom - Feet 155	


GEOLOGIC DATA (Office Use Only)			
Surface Elev.	Geologic Unit	Unit Thickness	Depth to Top
Subs. SWL	Date	Analysis	Aquifer Test
Driller's Remarks			
Top of Lap Pipe or Reduction in Casing			
FEET		IF TELESCOPED OR MORE THAN ONE SCREEN: USE BACK PAGE	

DESCRIPTION OF FORMATIONS ENCOUNTERED	FROM	TO
TOP SOIL	0	20
BROWN CLAY	20	40
GRAVEL	40	60
WHITE CLAY	60	100
WHITE SAND	100	155

FORMATIONS (Continued)	FROM	TO
RECEIVED		
JUN 05 2001		
Dspt. of Environmental Quality Office of Land & Water Resources		
IF MORE SPACE IS NEEDED, USE BACK		

If well telescopes please
sketch and show depths.

GROUND LEVEL

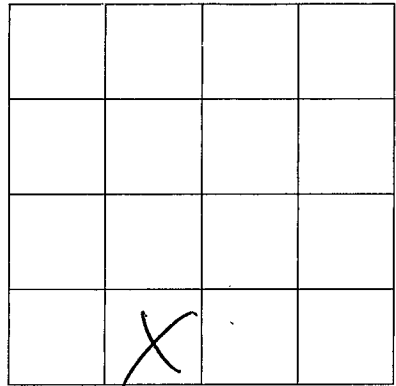

SECTION

C-20

Please indicate well location X.

ADDITIONAL INFORMATION

If more than one screen,
show location of each on sketch.