

MISSISSIPPI DEPARTMENT OF ENVIRONMENTAL QUALITY

Office of Land and Water Resources

P. O. Box 10631
Jackson, MS 39289-0631
WATER WELL DRILLERS LOG

COUNTY WELL LOCATED PAWOLA	
WELL NUMBER 453	CODED
C-25	
DATE WELL COMPLETED 8-19-03	

PERMIT NUMBER
NAME OF DRILLING FIRM SMITH Well DRILLING & SERV.

NAME & MAILING ADDRESS OF LANDOWNER (COLLINS) CITRUS COLLINS 6694 Compass Rd. Como			
Latitude:			
Longitude:			
WELL LOCATION	SEC	TOWNSHIP	RANGE
NWNW	C-26	T-6	R-7
DISTANCE DIRECTION NEAREST TOWN			
2 Miles	N-E	of Como	
OTHER LANDMARK 34-32-21 89-54-53			
WELL PURPOSE: Home, Irrigation, Municipal, Industrial, Fish Pond, etc. HOME			

PUMP DATA		
PUMP TYPE (Circle One): <input checked="" type="radio"/> Submersible Turbine Jet Flowing Well, Other (Describe) _____		
POWER TYPE (Circle One): <input checked="" type="radio"/> Electric Tractor, Diesel, Gasoline, Butane, Other (Describe) _____ H/P 3/4		
DESCRIPTION OF FORMATIONS ENCOUNTERED	FROM	TO
TOP SOIL	0	10
YELLOW CLAY	10	40
RED SANDS & GRAVEL	40	70
WHITE CLAY	70	90
WHITE SAND + CLAY	90	130
WHITE SAND	130	167
RECEIVED		
SEP 18 2003		
BY: OLWR		
Top of Lap Pipe or Reduction in Casing		
FEET	IF TELESCOPED OR MORE THAN ONE SCREEN: USE BACK PAGE	

WELL DATA		
Well Depth 167	Casing Diameter (In.) 4"	Casing Length (Ft.) 157
Type of Casing PVC	Hole Depth 167	Depth to Static Water Level 80'
TYPE OF COMPLETION: (Circle One or More): Gravel Packed, Underreamed, Telescoped, Natural Development, Open Hole, Other (Describe) WASHED SAND		
WELL GROUTED TO A DEPTH OF 10 FEET Type Grout (circle one): Cement , Bentonite, or Mix		

SCREEN DATA		
Diameter - Inches 4"	Length - Feet 10	Slot Size - Inches 147/325
Screen Type PVC	Depth to Bottom - Feet 167	

I certify that the well was drilled, constructed and completed in accordance with all applicable Requirements of the Mississippi Department of Environmental Quality and/or the Mississippi Department of Health regulations and state laws.


[Signature] **0-645**
Signature of Licensed Driller and License No.

8-20-03
Date

Additional Information Required On Back

If well telescopes please sketch and show depths.

GROUND LEVEL

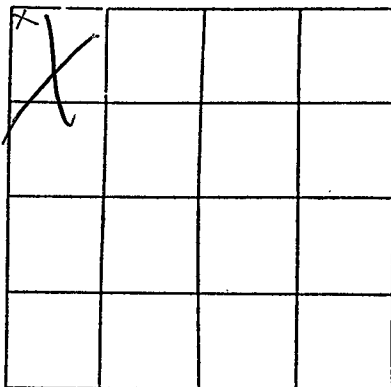

SECTION C-26

Please indicate well location X.

Pump Capacity (GPM)	No. of Stages	Setting Depth	
<u>12</u>	<u>10</u>	<u>100</u>	FT.
PUMP TEST			
Well yielded		<u>14</u>	GPM with
a drawdown of		<u>6</u>	ft.
after		<u>1</u>	hours of pumping

LOG DATA

TYPE OF LOG RUN (Circle One): No Log Run, Electric, Gamma Ray, Density, Sonic, Neutron, Other (Describe) _____

Name of Organization Running Log _____

GEOLOGIC DATA (Office Use Only)

Surface Elev.	Geologic Unit	Unit Thickness	Depth to Top
Subs. SWL	Date	Analysis	Aquifer Test

Driller's Remarks

If more than one screen, show location of each on sketch.