

# State Well Report

## Part 1

Mississippi Department of Environmental Quality  
 Office of Land and Water Resources  
 P.O. Box 10631  
 Jackson, MS 39289-0631  
 (601)961-5210  
 (601)954-6938 (fax)

For Office Use Only:

Aquifer: \_\_\_\_\_  
 Well #: C-34  
 L. S. Elevation: \_\_\_\_\_  
 E-log #: \_\_\_\_\_

County: Panola  
 Permit #: \_\_\_\_\_  
 Driller: BOB SMITH  
 Date drilling completed: 11-18-07

State Law requires that this report be prepared by the driller in detail and filed with the Department within 30 days of completion of drilling of the well.

Well Owner Information	Well Location
Owner Name: <u>Ralph Graham</u>	Latitude: _____ Longitude: _____
Mailing Address: <u>Compass Rd</u>	Method of Lat/Long (circle one): <input checked="" type="checkbox"/> Conventional Survey
<u>Como MS 38619</u>	<input type="checkbox"/> USGS quad, <input type="checkbox"/> Hand-held GPS, <input type="checkbox"/> Survey-grade GPS
City: _____ State: _____ Zip Code: _____	<u>1/4</u> <u>1/4</u> Sec <u>C26</u> Twn <u>T65</u> Rng <u>R9W</u>
Telephone No. <u>(662) 562-2276</u>	Distance: <u>3</u> Miles Direction: <u>N/E</u> of Nearest Town: <u>Como</u>

**Well Data**

Purpose of Well (circle one) Home Industrial Public Supply Irrigation Fish Culture Other: HUNTING CLUB

Date well drilling started: 11-18-07 Date well drilling completed: 11-18-07

If flowing, method of flow regulation: Valve \_\_\_\_\_ Other (describe) \_\_\_\_\_

Static Water Level: 80 feet above or below (circle one) land surface Date measured: 11-18-07

Method of Measurement (circle one) steel tape  electric tape \_\_\_\_\_ air line \_\_\_\_\_ other: \_\_\_\_\_

Hole depth: 175 Well depth: 175 Well grouted to a depth of 10 feet

Type of grout (circle one):  Cement Bentonite Mix

Casing length: 165 feet Casing diameter: 4 inches Type of casing: PVC

Screen length: 10 feet Screen diameter: 4 inches Type of screen: PVC

Screen slot size: 137005 inches Setting depth: From 165 feet to 175 feet

Type of completion (circle all applicable): Gravel packed Underreamed Telescoped Open hole Natural Development

Other (describe): WASHED SAND

Top of lap pipe or reduction in casing: \_\_\_\_\_ feet. If telescoped or more than one screen, describe on back of page

Logs run (circle all applicable): No log run Electric Gamma Ray Density Sonic Neutron Other: \_\_\_\_\_

Name of organization running log(s): \_\_\_\_\_

I certify that the well was drilled, constructed, and completed in accordance with all applicable requirements of the Mississippi Department of Environmental Quality and/or the Mississippi Department of Health regulations and state laws.


BOB SMITH 0-645  
 Print Name of Water Well Contractor and License No.

[Signature]  
 Signature of Water Well Contractor

RECEIVED  
 DEC 18 2007  
 BY: OLWA


If well telescopes please sketch below and show depths.

Ground Level

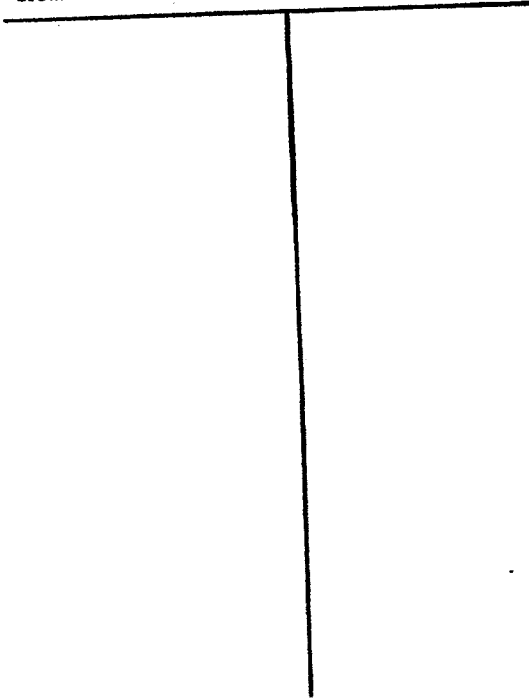

Description of Formations Encountered	From	To
TOP SOIL	0	5
BROWN CLAY	5	22
RED SAND + GRAVEL	22	57
WHITE CLAY	57	108
WHITE SAND + CLAY	108	146
WHITE SAND	146	175

If more than one screen, show location of each on sketch

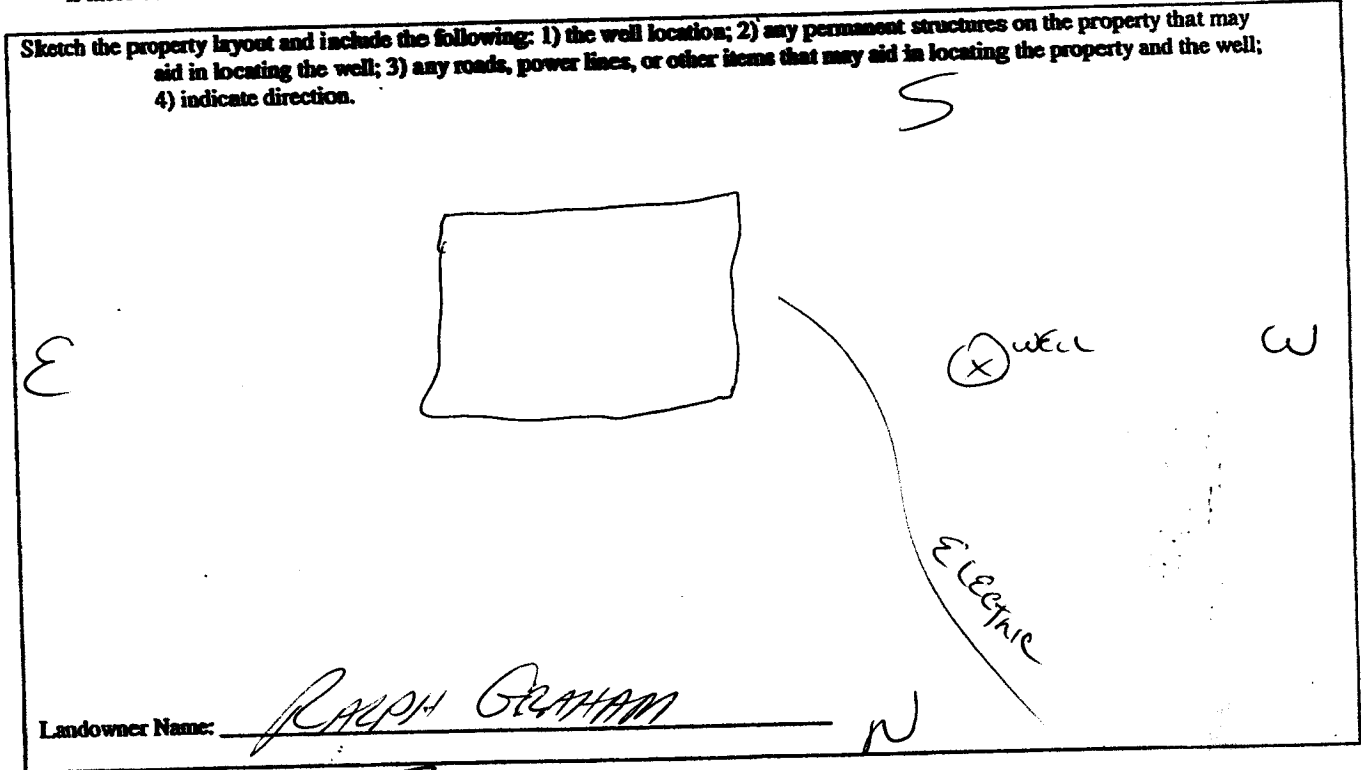

Signature of Water Well Contractor

RECEIVED  
DEC 18 2007  
BY: OLWR

# STATE WELL REPORT

## Part 2

Pump Installer's Completion Report  
Mississippi Department of Environmental Quality  
Office of Land and Water Resources  
P.O. Box 10631  
Jackson, MS 39289-0631  
(601)961-5210  
(601)354-6938 (fax)

For Office Use Only:

Aquifer: \_\_\_\_\_

Well #: C-34

Elevation: \_\_\_\_\_

County: PANOLA  
Permit #: \_\_\_\_\_  
Driller: BOB SMITH  
Date completed: 11-18-07

This report should be prepared by the pump installer in detail and filed with the Department within 30 days of the installation of pump.

Well Owner Information	Well Location
Owner Name: <u>RALPH DEANAN</u>	Latitude: _____ Longitude: _____
Mailing Address: <u>Compass rd</u>	Method of Lat/Long (circle one): Conventional Survey,
<u>Como, MS 38619</u>	USGS quad, Hand-held GPS, Survey-grade GPS
City State Zip Code	<u>14 14 Sec C26 Twn T65 Rng R7W</u>
Telephone No. <u>(662) 562-2776</u>	Distance Direction Nearest Town
	<u>3 Miles N/E of Como</u>

Pump Type Circle one	Power Type Circle one
Air Lift Jet <input checked="" type="radio"/> Submersible	Diesel Engine Gasoline Engine Natural Gas
Bucket Piston Turbine	<input checked="" type="radio"/> Electric Motor Hand Tractor PTO
Centrifugal Rotary Flowing Well	Windmill Other (specify): _____
Other (specify): _____	Horse Power Rating of Motor: <u>1 1/2</u>
Date Pump Installed: <u>11-18-07</u>	Setting Depth: <u>100</u> feet
Rated Pump Capacity: <u>20</u> Gallons Per Minute	Number of Stages: <u>14</u>

Pump Test Data	Method of Measuring Water Level Circle one
Date Well Tested: <u>11-18-07</u>	Air Line <input checked="" type="radio"/> Electric Measuring Line Steel Tape
Static Water Level (A): <u>80</u> Feet Below Land Surface	Other (specify): _____
Pumping Water Level (B): <u>86</u> Feet Below Land Surface	For flowing well, measured shut in head: _____ feet
Drawdown [(B) - (A)]: <u>6</u> Feet Below Land Surface	Well yielded <u>27</u> GPM with a drawdown of
Test Pumping Rate: <u>27</u> Gallons Per Minute	<u>6</u> feet after _____ hours of pumping
Duration of Pump Test (minimum 4 hours): _____ hours	

I HEREBY CERTIFY that the above statements are true to the best of my knowledge.  
Bob Smith 0645  
Print Name of Pump Installer and License No. (if applicable) Signature of Pump Installer

RECEIVED  
DEC 18 2007  
BY OLWR