

PANOLA
 C 2000
 5/6/76

MISSISSIPPI
 BOARD OF WATER COMMISSIONERS
 416 North State Street
 Jackson, Mississippi 39201

WATER WELL DRILLERS LOG


May 6 1976 North Miss Water Well Panola
 date well completed firm name county well located

LANDOWNER: <i>John Orr</i> <i>Camo</i>	description of formations encountered	from	to
(mailing address)	<i>Clay</i>	0	15
WELL LOCATION: sec. <i>29</i> T <i>6</i> N R <i>7</i> E <i>1</i> miles <i>N</i> of <i>Camo</i> (distance) (direction) (nearest town)	<i>Sand</i>	15	45
WELL PURPOSE: (home, irrigation, municipal, industrial)	<i>Gravel</i>	45	120
WELL COMPLETION DATA: (1) diameter (inches) <i>4"</i> (2) total depth (feet) <i>162</i> (3) static water level (feet) <i>90</i> below above top of ground. (4) casing <i>Plastic</i> , <i>162</i> (material) (depth) (size) If telescope see back. (5) screen <i>10'</i> (length) (depth to top) <i>1"</i> <i>SLOT Plastic</i> (size) (material) (6) pump <i>34</i> <i>10</i> (HP) (yield gpm) <i>Elec</i> (type power) (7) electric log <i>No</i> (yes or no) (organization running log) (8) how well bottom plugged <i>Plug</i>	<i>Water Sand</i>	120	162
DRILLERS REMARKS:			

MISS. BD. OF WATER COMM.

If well telescopes please sketch and show depths.

GROUND LEVEL

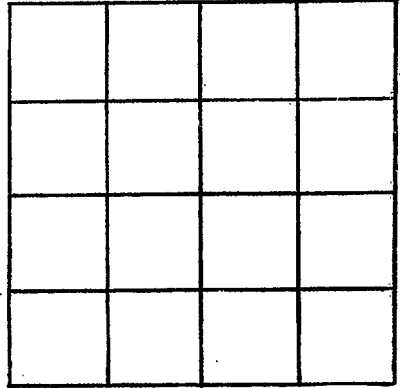

SECTION _____

Please indicate well location X.

ADDITIONAL INFORMATION

If more than one screen, show locations of each on sketch.