

**MISSISSIPPI
BOARD OF WATER COMMISSIONERS**
416 North State Street
Jackson, Mississippi 39201

15E

WATER WELL DRILLERS LOG

Panola
C 2001
11-24-76

11-24 1976 Harris Bros Panola
 date well completed firm name county well located

LANDOWNER: N.A. Sledge
pt 1
Como
 (mailing address)

WELL LOCATION:
 sec. 30 T. 6 N. R. 7 E.
2 miles E of Como
 (distance) (direction) (nearest town)

WELL PURPOSE: home
 (home, irrigation, municipal, industrial)

WELL COMPLETION DATA:

(1) diameter (inches) 4

(2) total depth (feet) 130

(3) static water level (feet) 100 below above
 top of ground.

(4) casing Plastic 127
 (material) (depth)
4 if telescope see back.
 (size)

(5) screen 7 123
 (length) (depth to top)
008 Plastic
 (size) (material)

(6) pump 3/4 10
 (HP) (yield gpm)
elec.
 (type power)

(7) electric log no
 (yes or no)

(organization running log)

(8) how well bottom plugged solid


description of formations encountered	from	to
<u>top soil</u>	<u>0</u>	<u>25</u>
<u>sand + gravel</u>	<u>25</u>	<u>70</u>
<u>sand + clay</u>	<u>70</u>	<u>110</u>
<u>Coarse sand</u>	<u>110</u>	<u>130</u>

DRILLERS REMARKS:

RECEIVED
 MAY 26 1977

If well telescopes please sketch and show depths.

GROUND LEVEL

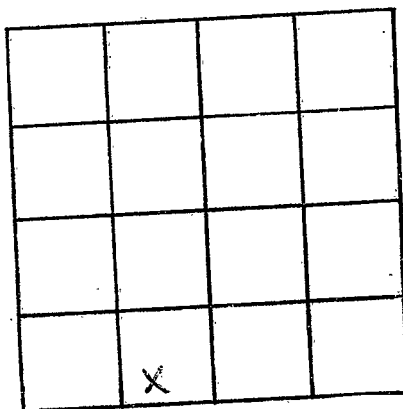

SECTION 36

Please indicate well location X.

ADDITIONAL INFORMATION

If more than one screen, show locations of each on sketch.