

PANOLA
 C 2005
 2-02-79

MISSISSIPPI
 BOARD OF WATER COMMISSIONERS
 416 North State Street
 Jackson, Mississippi 39201

WATER WELL DRILLERS LOG

2-2-79 High Well Co Panola
 date well completed firm name county well located

LANDOWNER: Albert Sides
208 Dilmore
Senatobia, Ms. 38668
 (mailing address)

description of formations encountered	from	to
Red clay	0	15
Gravel	15	70
Clay + sand	70	100
white sand	100	140

WELL LOCATION:
 sec. 22 T. 6 N. R. 7 E.
7 miles S of Senatobia
 (distance) (direction) (nearest town)

WELL PURPOSE: Home
 (home, irrigation, municipal, industrial)

WELL COMPLETION DATA:

(1) diameter (inches) 4

(2) total depth (feet) 140

(3) static water level (feet) 60 below above top of ground.

(4) casing PVC 140
 (material) (depth)
 (size) if telescope see back.

(5) screen 14 126
 (length) (depth to top)
4 gravel type
 (size) (material)

(6) pump 1 18
 (HP) (yield gpm)
220V
 (type power)

(7) electric log No.
 (yes or no)

(organization running log)

(8) how well bottom plugged Cap

DRILLERS REMARKS:


Miss. Board of Water Comm.

FEB 22 1979

RECEIVED

If well telescopes please sketch and show depths.

GROUND LEVEL

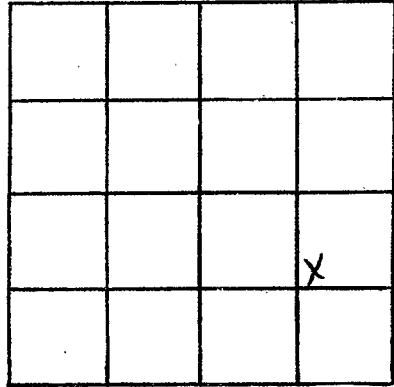

SECTION *22*

Please indicate well location X.

ADDITIONAL INFORMATION

If more than one screen, show locations of each on sketch.