

PANOLA
C 2006
4-5-79

MISSISSIPPI
BOARD OF WATER COMMISSIONERS
416 North State Street
Jackson, Mississippi 39201



WATER WELL DRILLERS LOG

4-5-79 1979 High Well Co Panola
date well completed firm name county well located

LANDOWNER:
Jerry Handlin
Rt. 2, Box 6 AA, Como
(mailing address)

| description of formations encountered | from | to |
|---------------------------------------|------|-----|
| Clay | 0 | 30 |
| Miss sand & clay | 30 | 60 |
| Clay | 60 | 90 |
| White clay & sand | 90 | 105 |
| White sand | 105 | 125 |

WELL LOCATION:
sec. 31 T-6 N-2 E
2 miles West of Como
(distance) (direction) (nearest town)

WELL PURPOSE: Home
(home, irrigation, municipal, industrial)

- WELL COMPLETION DATA:
- (1) diameter (inches) 4 in.
 - (2) total depth (feet) 125
 - (3) static water level (feet) 40 below top of ground.
 - (4) casing (material) Plastic (depth) 125
 - (size) If telescope see back.
 - (5) screen 7 ft (length) 118 ft (depth to top)
 - (size) (material)
 - (6) pump 1/2 (HP) 10 (yield gpm)
 - 220 (type power)
 - (7) electric log No (yes or no)
 - (organization running log)
 - (8) how well bottom plugged Cap.

Miss. Board of Water Comm.


APR 9 - 1979

DRILLERS REMARKS:

RECEIVED

If well telescopes please sketch and show depths.

GROUND LEVEL

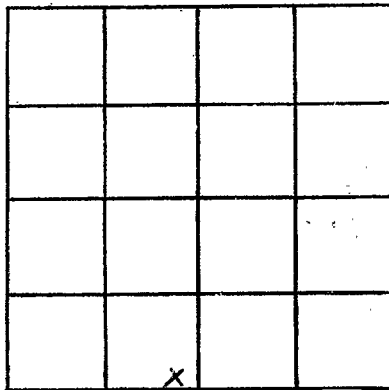

SECTION 30

Please indicate well location X.

ADDITIONAL INFORMATION

If more than one screen, show locations of each on sketch.