

Panola  
C  
2007  
4/5/79

MISSISSIPPI  
BOARD OF WATER COMMISSIONERS  
416 North State Street  
Jackson, Mississippi 39201

WATER WELL DRILLERS LOG

4/5 1979 <sup>Rich's Well Co.</sup> Ammie B. Young Panola  
date well completed firm name county well located

LANDOWNER:  
Ammie B. Young  
P.O. Box 64, Coma  
(mailing address)

WELL LOCATION:  
sec. 30 T. 6 N. R. 7 E. W. 2  
2 miles West of Coma  
(distance) (direction) (nearest town)

WELL PURPOSE: Home  
(home, irrigation, municipal, industrial)

WELL COMPLETION DATA:  
(1) diameter (inches) 4 in  
(2) total depth (feet) 125  
(3) static water level (feet) 40 below above top of ground.  
(4) casing Plastic 125 (material) (depth)  
(size) if telescope see back.  
(5) screen 10 ft 110 ft (length) (depth to top)  
4 in. galvanized (size) (material)  
(6) pump 1/2 10 (HP) (yield gpm).  
220 (type power)  
(7) electric log No (yes or no)  
(organization running log)  
(8) how well bottom plugged Cap.

description of formations encountered	from	to
Clay	0	30
Clay + sand	30	60
Clay	60	90
White sand + clay	90	105
White sand	105	125

Miss. Board of Water Comm.


APR 9 - 1979

RECEIVED

DRILLERS REMARKS:

If well telescopes please sketch and show depths.

GROUND LEVEL:

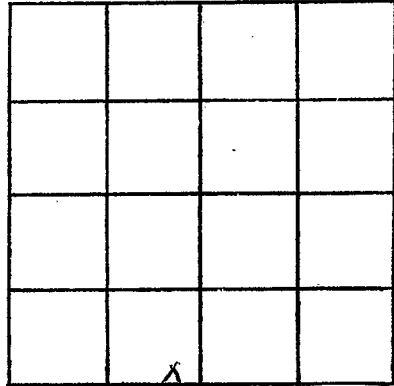

SECTION 30

Please indicate well location X.

ADDITIONAL INFORMATION

If more than one screen, show locations of each on sketch.