

Panola
C 2010
5-13-80

MISSISSIPPI
 BOARD OF WATER COMMISSIONERS
 416 North State Street
 Jackson, Mississippi 39201

WATER WELL DRILLERS LOG

4-22

1980 Hills Well Co.

Panola

date well completed

firm name

county well located

LANDOWNER:

Yvonne Rodgers
Rt. 2, Cama.
 (mailing address)

description of formations encountered

from to

description of formations encountered	from	to
<u>clay</u>	<u>0</u>	<u>20</u>
<u>gravel</u>	<u>20</u>	<u>85</u>
<u>white sand</u>	<u>85</u>	<u>125</u>

WELL LOCATION:

sec. 30 T. 6 N. R. 7 E
1 1/2 miles W of Cama
 (distance) (direction) (nearest town)

WELL PURPOSE: home
 (home, irrigation, municipal, industrial)

WELL COMPLETION DATA:

- (1) diameter (inches) 4 in
- (2) total depth (feet) 125
- (3) static water level (feet) 90 below above top of ground.
- (4) casing Plastic 125
 (material) (depth)
 (size) if telescope see back.
- (5) screen 7 ft 1/8
 (length) (depth to top)
4 in Gravel
 (size) (material)
- (6) pump 1/2 10
 (HP) (yield gpm)
220
 (type power)
- (7) electric log No
 (yes or no)

(organization running log)

(8) how well bottom plugged Cap

DRILLERS REMARKS:


DEPT. OF NATURAL RESOURCES
 BUREAU OF LAND & WATER RESOURCES

MAY 12 1980

RECEIVED

If well telescopes please sketch and show depths.

GROUND LEVEL

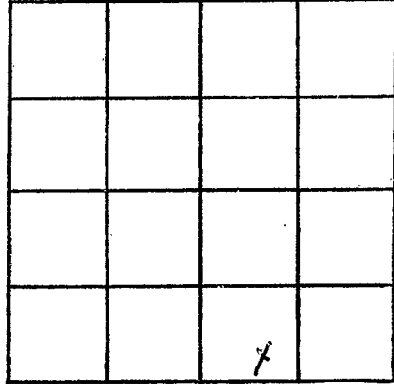

SECTION 30

Please indicate well location X.

ADDITIONAL INFORMATION

If more than one screen, show locations of each on sketch.