

Panola  
C 2012  
8-18-80

MISSISSIPPI  
BOARD OF WATER COMMISSIONERS  
416 North State Street  
Jackson, Mississippi 39201

WATER WELL DRILLERS LOG

8-18 19 80 High Well Co. Panola  
date well completed firm name county well located

LANDOWNER: <u>James Henderson</u>	description of formations encountered	from	to
<u>Bl. 1</u>			
<u>Como, Ms.</u> (mailing address)	<u>Clay</u>	<u>0</u>	<u>30</u>
	<u>land</u>	<u>30</u>	<u>110</u>

WELL LOCATION:

sec 27 T 6 N R 27 E  
2 miles NE of Como  
 (distance) (direction) (nearest town)

WELL PURPOSE: Home  
 (home, irrigation, municipal, industrial)


- WELL COMPLETION DATA:
- (1) diameter (inches) 4
  - (2) total depth (feet) 155
  - (3) static water level (feet) 100 below above top of ground.
  - (4) casing PVC 155  
 (material) (depth)  
 (size) if telescope: see back.
  - (5) screen 7' 148  
 (length) (depth to top)  
4" gravel type  
 (size) (material)
  - (6) pump 1/2 10  
 (HP) (yield gpm)  
200W  
 (type power)
  - (7) electric log No.  
 (yes or no)
  - (8) how well bottom plugged Cap

DRILLERS REMARKS:

DEPARTMENT OF NATURAL RESOURCES  
 DIVISION OF WATER RESOURCES  
 SEP 29 1980  
**RECEIVED**

If well telescopes please sketch and show depths.

GROUND LEVEL

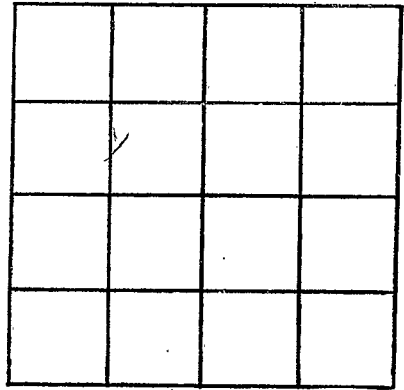

SECTION *24*

Please indicate well location X.

ADDITIONAL INFORMATION

If more than one screen, show locations of each on sketch.