

MISSISSIPPI DEPARTMENT OF NATURAL RESOURCES
 Bureau of Land and Water Resources
 Southport Mall
 P.O. Box 10631
 Jackson, Mississippi 39209
WATER WELL DRILLERS LOG

PANOLA
 C 2013
 11-21-80

11-21-1980 date well completed Hicks Well Co. firm name Panola county well located

LANDOWNER: Hollie Bold Browder
 Rt. 1
Came, Ms.
 (mailing address)
 WELL LOCATION:
 sec 25 T. 6 N. R. 7 E. W. 3
3 miles E of Came
 (distance) (direction) (nearest town)

description of formations encountered	depth	
	from	to
Red clay	0	10
Red sand	10	65
Shale	65	95
White sand	95	157

WELL PURPOSE: Home
 (home, irrigation, municipal, industrial)

WELL COMPLETION DATA:
 (1) diameter (inches) 4
 (2) total depth (feet) 157
 (3) static water level (feet) 96 below above top of ground.
 (4) casing PVC, 157,
 (material) (depth)
 _____ If telescope see back.
 (size)
 (5) screen 10, 141
 (length) (depth to top)
4", iron pipe
 (size) (material)
 (6) pump 1/2, 10
 (HP) (yield gpm)
220V
 (type power)
 (7) electric log No
 (yes or no)

 (organization running log)
 (8) how well bottom plugged Cap

DRILLERS REMARKS:


DEPT. OF NATURAL RESOURCES
 BUREAU OF LAND & WATER RESOURCES

DEC - 3 1980

RECEIVED

If well telescopes please sketch and show depths.

GROUND LEVEL

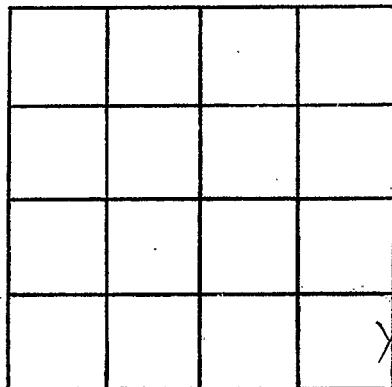

SECTION 25

Please indicate well location X.

ADDITIONAL INFORMATION

If more than one screen,
show locations of each on sketch.