

MISSISSIPPI DEPARTMENT OF NATURAL RESOURCES

Bureau of Land and Water Resources

Southport Mall

P.O. Box 10631


Jackson, Mississippi 39209

WATER WELL DRILLERS LOG

PANOLA  
C 2015  
5/29/81


5/29 1981 date well completed  
Hicks Well Co. firm name  
Panola county well located

LANDOWNER: <u>Ruby Lane</u>	description of formations encountered	from	to
<u>Rt. 2</u>			
<u>Como, Mo.</u> (mailing address)	<u>Red Clay + Sand</u>	<u>0</u>	<u>30</u>
WELL LOCATION:	<u>Gravel</u>	<u>30</u>	<u>95</u>
sec. <u>29</u> T. <u>6</u> N R. <u>7</u> E <u>2</u> miles <u>W</u> of <u>Como</u> (distance) (direction) (nearest town)	<u>White Sand</u>	<u>95</u>	<u>175</u>
WELL PURPOSE: <u>Home</u> (home, irrigation, municipal, industrial)			
WELL COMPLETION DATA:			
(1) diameter (inches) <u>4</u>			
(2) total depth (feet) <u>175</u>			
(3) static water level (feet) <u>100</u> below top of ground.			
(4) casing <u>PVC</u> , <u>175</u> , (material) (depth) <u>4</u> if telescope see back. (size)			
(5) screen <u>10'</u> , <u>165</u> (length) (depth to top)			
(6) pump <u>1/2</u> , <u>10</u> (HP) (yield gpm)			
<u>220V</u> (type power)			
(7) electric log <u>No</u> (yes or no)			
(organization running log)			
(8) how well bottom plugged <u>Cap</u>			
DRILLERS REMARKS:			

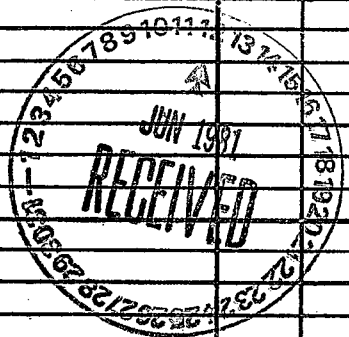

If well telescopes please sketch and show depths.

GROUND LEVEL

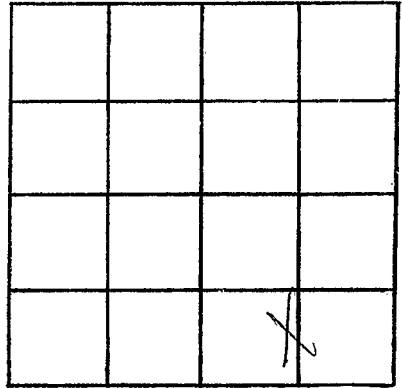

SECTION 29

Please indicate well location X.

ADDITIONAL INFORMATION

If more than one screen,  
show locations of each on sketch.