

MISSISSIPPI DEPARTMENT OF NATURAL RESOURCES

Bureau of Land and Water Resources

Southport Mall

P.O. Box 10631

Jackson, Mississippi 39209

WATER WELL DRILLERS LOG

*Parola*  
 2016

2-20-1982 *B. Bob Smith Parola*  
 date well completed firm name county well located

LANDOWNER:

*Alan Fitzgerald*  
*Como, Miss.*  
 (mailing address)

description of formations encountered

from to

<i>top soil</i>	<i>0</i>	<i>5</i>
<i>red clay</i>	<i>5</i>	<i>30</i>
<i>gravel</i>	<i>30</i>	<i>73</i>
<i>white clay</i>	<i>73</i>	<i>120</i>
<i>sand</i>	<i>120</i>	<i>165</i>

WELL LOCATION:

sec. 31 T. 6 N. R. 7 E.  
 (distance) miles (direction) of (nearest town)  
*5* miles *W* of *Como*

WELL PURPOSE:

(home, irrigation, municipal, industrial)  
*home*

WELL COMPLETION DATA:

- (1) diameter (inches) *4"*
- (2) total depth (feet) *165'*
- (3) static water level (feet) *100'* *below* above top of ground.
- (4) casing *plastic* *165'*  
 (material) (depth)  
 \_\_\_\_\_ if telescope see back.  
 (size)
- (5) screen *20'* *145'*  
 (length) (depth to top)  
*4"* *plastic*  
 (size) (material)
- (6) pump *1/2* *10*  
 (HP) (yield gpm)  
*ell.*  
 (type power)
- (7) electric log *(yes or no)*

(organization running log)

(8) how well bottom plugged *Cap*

DEPT. OF NATURAL RESOURCES  
 BUREAU OF LAND & WATER RESOURCES


OCT 12 1982

RECEIVED

DRILLERS REMARKS:

If well telescopes please sketch and show depths.

GROUND LEVEL

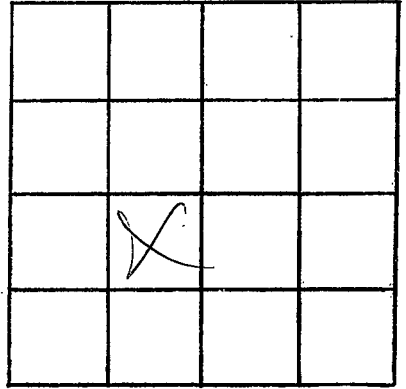

SECTION \_\_\_\_\_

Please indicate well location X.

ADDITIONAL INFORMATION

If more than one screen,  
show locations of each on sketch.