

MISSISSIPPI DEPARTMENT OF NATURAL RESOURCES

Bureau of Land and Water Resources

Southport Mall

P.O. Box 10631

Jackson, Mississippi 39209

WATER WELL DRILLERS LOG

Panola
C
2017

HICKS WELL CO.

INC. 1 Dec 1977

Senatobia, MS 38668

Panola

8-24 1903
 date well completed

county well located

LANDOWNER: <u>Willie Finley</u>	description of formations encountered	from	to
<u>Pt. 2</u>			
<u>Cono, Ms. 38619</u> (mailing address)	<u>Red Clay</u>	<u>0</u>	<u>20</u>
WELL LOCATION: sec. <u>30</u> T <u>6</u> N R <u>7</u> E <u>1</u> miles <u>W</u> of <u>Cono</u> (distance) (direction) (nearest town)	<u>Red Sand</u>	<u>20</u>	<u>35</u>
WELL PURPOSE: <u>Home</u> (home, irrigation, municipal, industrial)	<u>Gravel</u>	<u>35</u>	<u>80</u>
WELL COMPLETION DATA: (1) diameter (inches) <u>4</u>	<u>White Sand</u>	<u>80</u>	<u>155</u>
(2) total depth (feet) <u>155</u>			
(3) static water level (feet) <u>100</u> ^{below} / _{above} top of ground.			
(4) casing <u>PVC</u> , <u>155</u> (material) (depth)			
<u>4"</u> (size) if telescope see back.			
(5) screen <u>10'</u> , <u>145</u> (length) (depth to top)			
<u>1013</u> , <u>PVC</u> (size) (material)			
(6) pump <u>1/2</u> , <u>10</u> (HP) (yield gpm)			
<u>220V</u> (type power)			
(7) electric log <u>No</u> (yes or no)			
(organization running log)			
(8) how well bottom plugged <u>Cap</u>			
DRILLERS REMARKS:			


DEPT. OF NATURAL RESOURCES
 BUREAU OF LAND & WATER RESOURCES

SEP 22 1903

RECEIVED

If well telescopes please sketch and show depths.

GROUND LEVEL

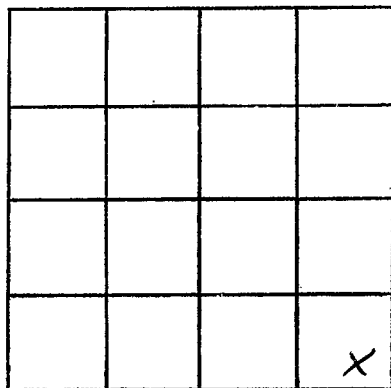

SECTION 30

Please indicate well location X.

ADDITIONAL INFORMATION

If more than one screen,
show locations of each on sketch.