

MISSISSIPPI DEPARTMENT OF NATURAL RESOURCES

Bureau of Land and Water Resources

Southport Mall

P.O. Box 10631

Jackson, Mississippi 39209

WATER WELL DRILLERS LOG

Panola
C
2018

HICKS WELL CO.
firm name
P.O. Box 137
Senatobia, MS 38668

Panola

10-7 1983
date well completed

county well located

LANDOWNER: E.P. Taylor

description of formations encountered

from to

P.O. Box 131

Red Clay 0 20

Cons, Mo. 38619
(mailing address)

Red sand 20 35

WELL LOCATION:

sec. 30 T. 6 N. R. 7 E.
1 miles NW of Como
(distance) (direction) (nearest town)

Gravel 35 65

White clay & sand 65 125

WELL PURPOSE: Home
(home, irrigation, municipal, industrial)

White sand 125 155

WELL COMPLETION DATA:

(1) diameter (inches) 4
(2) total depth (feet) 155
(3) static water level (feet) 80 below above top of ground.

(4) casing PVC, 155
(material) (depth)
4"
(size) if telescope see back.

(5) screen 10", 145'
(length) (depth to top)
1813, PVC
(size) (material)

(6) pump 1/2 10
(HP) (yield gpm)
220V
(type power)

(7) electric log No
(yes or no)

(organization running log)

(8) how well bottom plugged Cap


DRILLERS REMARKS:

DEPT. OF NATURAL RESOURCES
BUREAU OF LAND & WATER RESOURCES

OCT 13 1983
RECEIVED

If well telescopes please sketch and show depths.

GROUND LEVEL

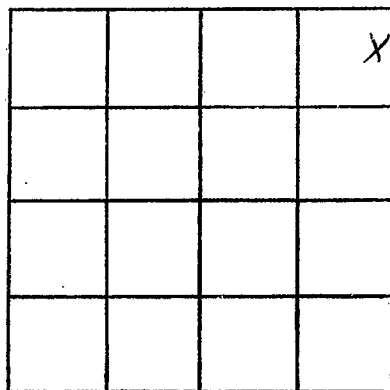

SECTION 30

Please indicate well location X.

ADDITIONAL INFORMATION

If more than one screen,
show locations of each on sketch.