

MISSISSIPPI DEPARTMENT OF NATURAL RESOURCES

Bureau of Land and Water Resources

Southport Mall

P.O. Box 10631

Jackson, Mississippi 39209

WATER WELL DRILLERS LOG

*Panola*  
C  
2019

4/13 1984  
date well completed

HICKS WELL CO.  
firm name Box 157  
Senatobia, MS 38668

*Panola*  
county well located

LANDOWNER: *Charlie Holden*

description of formations encountered	from	to
red clay	0	10
Red sand	10	60
white clay & sand	60	75
white sand	75	170

*Rt. 1*  
*Como, Ms. 38619*  
(mailing address)

WELL LOCATION:  
sec. 3 T. 6 N. R. 7  
5 1/2 miles E of Como  
(distance) (direction) (nearest town)

WELL PURPOSE: *Home*  
(home, irrigation, municipal, industrial)

- WELL COMPLETION DATA:
- (1) diameter (inches) 4
  - (2) total depth (feet) 170
  - (3) static water level (feet) 140 <sup>below</sup>/<sub>above</sub> top of ground.
  - (4) casing PVC, 170,  
(material) (depth)  
4" if telescope see back.  
(size)
  - (5) screen 10', 160'  
(length) (depth to top)  
0.10, PVC  
(size) (material)
  - (6) pump 3/4, 10  
(HP) (yield gpm)  
220  
(type power)
  - (7) electric log No  
(yes or no)

(organization running log)

(8) how well bottom plugged *Cap*

DRILLERS REMARKS:


DEPT. OF NATURAL RESOURCES  
BUREAU OF LAND & WATER RESOURCES

MAY - 9 1984

RECEIVED

If well telescopes please sketch and show depths.

GROUND LEVEL

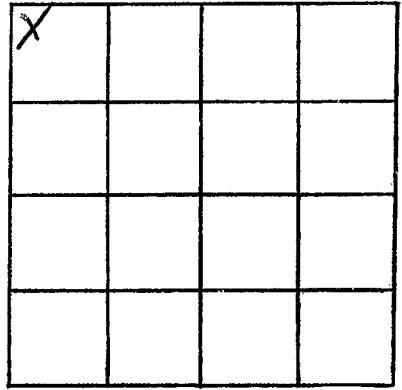

SECTION 3

Please indicate well location X.

ADDITIONAL INFORMATION

If more than one screen, show locations of each on sketch.