

MISSISSIPPI DEPARTMENT OF NATURAL RESOURCES

Bureau of Land and Water Resources

Southport Mall

P.O. Box 10631

Jackson, Mississippi 39209

WATER WELL DRILLERS LOG

C 7020

PANOLA

Panola

12-11-84
date well completed

WATER WELL CO.
firm name
Box 157

county well located

LANDOWNER: Linda Jackson

description of formations encountered

from to

Rt. 2

Como, Ms. 38619
(mailing address)

Red Clay

0 10

Red Sand

10 20

WELL LOCATION:

sec. 30 6 N R 7 E
1 1/2 miles W of Como
(distance) (direction) (nearest town)

Gravel

20 60

~~Red Sand~~ white sand & clay

60 80

WELL PURPOSE: Home
(home, irrigation, municipal, industrial)

white sand

80 128

WELL COMPLETION DATA:

(1) diameter (inches) 4
(2) total depth (feet) 128
(3) static water level (feet) 100 ^{below} _{above} top of ground.

(4) casing PVC, 128
(material) (depth)
4"
(size) if telescope see back.

(5) screen 10', 118'
(length) (depth to top)
0.10, PVC
(size) (material)

(6) pump 1/2, 10
(HP) (yield gpm)
220V
(type power)

(7) electric log No
(yes or no)

(organization running log)

(8) how well bottom plugged Cap


DRILLERS REMARKS:

RECEIVED
MAR 14 1985

Department of Natural Resources
Bureau of Land & Water Resources

If well telescopes please sketch and show depths.

GROUND LEVEL

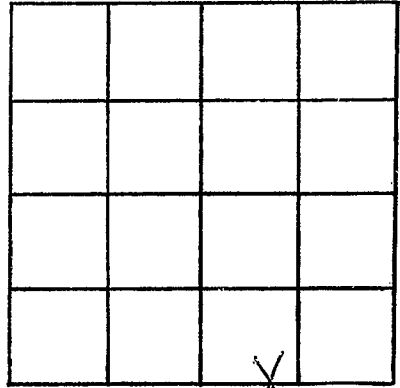

SECTION 30

Please indicate well location X.

ADDITIONAL INFORMATION

A series of horizontal lines for writing additional information.

If more than one screen, show locations of each on sketch.