

MISSISSIPPI DEPARTMENT OF NATURAL RESOURCES

Bureau of Land and Water Resources

Southport Mall

P.O. Box 10631

Jackson, Mississippi 39209

WATER WELL DRILLERS LOG

PANOLA
C. 2022

11-15-85
date well completed

LIFE WELL & SUPPLY
firm name

PANOLA
county well located

LANDOWNER: ASSOCIATED
WAREHOUSES - TB&ESTATE
PLACE #1 MEMPHIS, TN
(mailing address)

WELL LOCATION:
sec. 28 T. 6 N. R. 7 E
1 miles N of COMO
(distance) (direction) (nearest town)

WELL PURPOSE: INDUSTRIAL
(home, irrigation, municipal, industrial)

- WELL COMPLETION DATA:
- (1) diameter (inches) 4"
 - (2) total depth (feet) 162'
 - (3) static water level (feet) 80' below top of ground.
 - (4) casing PVC, 142'
(material) (depth)
(size) If telescope see back.
 - (5) screen 20, 142'
(length) (depth to top)
4", PVC
(size) (material)
 - (6) pump 7 1/2, 80
(HP) (yield gpm)
230V 1Ø
(type power)
 - (7) electric log NO
(yes or no)
(organization running log)
 - (8) how well bottom plugged CAP

description of formations encountered	from	to
top soil & clay	0	15
sand mix clay	15	20
sand	20	35
gravel	35	40
gravel & sand	40	57
clay	57	60
sand & pea gravel	80	100
" "	100	120
clay	120	135
sand	135	140
sand	140	162


RECEIVED
MAY 19 1986

Department of Natural Resources
Bureau of Land & Water

DRILLERS REMARKS:
OLD FEDERAL COMPLEX

If well telescopes please sketch and show depths.

GROUND LEVEL

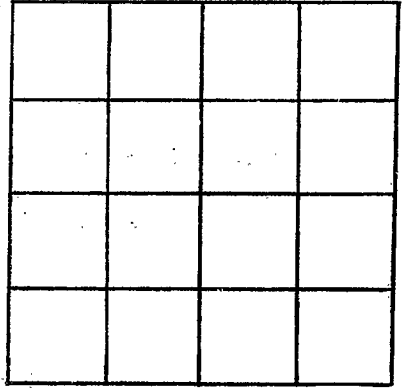

SECTION _____

Please indicate well location X.

ADDITIONAL INFORMATION

If more than one screen, show locations of each on sketch.