

MISSISSIPPI DEPARTMENT OF NATURAL RESOURCES

Bureau of Land and Water Resources

Southport Mall

P.O. Box 10631

Jackson, Mississippi 39209

WATER WELL DRILLERS LOG

PAOLA  
C  
2023

6-21-85 1985 LIFE WELL & SUPPLY PAOLA  
 date well completed firm name county well located

LANDOWNER: MIKE SUMNER

description of formations encountered	from	to
clay	0	20
red sand	20	30
"	30	40
"	40	55
gravel	55	60
"	60	70
clay	70	80
peg gravel	80	100
sand	100	120
sand	120	140
" " "	140	145


CONRO, MS  
 (mailing address)

WELL LOCATION:  
 sec 29 T 6 N R 7 E  
10 miles W of CONRO  
 (distance) (direction) (nearest town)

WELL PURPOSE: HOME  
 (home, irrigation, municipal, industrial)

WELL COMPLETION DATA:

- (1) diameter (inches) 4
- (2) total depth (feet) 145
- (3) static water level (feet) 87 below above top of ground.
- (4) casing PVC, 135,  
 (material) (depth)  
4 if telescope see back.  
 (size)
- (5) screen 10, 135  
 (length) (depth to top)  
4", PVC  
 (size) (material)
- (6) pump 1 1/2, 18  
 (HP) (yield gpm)  
230V 1Ø  
 (type power)
- (7) electric log NO  
 (yes or no)  
 (organization running log)
- (8) how well bottom plugged CAP

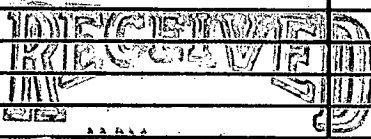


MAY 19 1985

DRILLERS REMARKS:

Department of Natural Resources  
 Bureau of Land & Water Resources

If well telescopes please  
sketch and show depths.

GROUND LEVEL

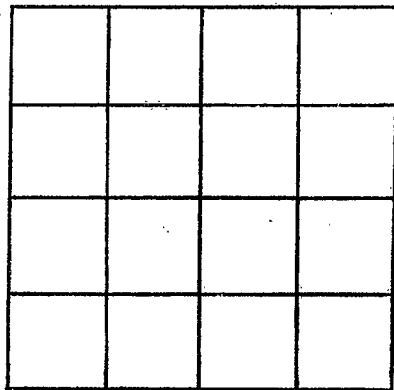

SECTION \_\_\_\_\_

Please indicate well location X.

ADDITIONAL INFORMATION

If more than one screen,  
show locations of each on sketch.