

MISSISSIPPI DEPARTMENT OF NATURAL RESOURCES
Bureau of Land and Water Resources

P.O. Box 10631
Jackson, Mississippi 39209
WATER WELL DRILLERS LOG

COUNTY WELL LOCATED <i>Parola</i>	
WELL NUMBER <i>C 2027</i>	CODED
DATE WELL COMPLETED <i>8-18-88</i>	

PERMIT NUMBER
NAME OF DRILLING FIRM <i>HICKS WELL COMPANY</i> <i>RT. 1, BOX 157</i>

NAME & MAILING ADDRESS OF LANDOWNER <i>Alma Hunt</i> <i>Rt. 1</i> <i>Como, Ms. 38619</i>		
WELL LOCATION: SEC	TOWNSHIP	RANGE
<i>30</i>	<i>6 N</i>	<i>7 E</i>
DISTANCE <i>1 1/2</i> Miles	DIRECTION <i>NW</i>	NEAREST TOWN <i>Como</i>
OTHER LANDMARK		
WELL PURPOSE: <i>Home</i> Irrigation, Municipal, Industrial, Fish Pond, etc.		

PUMP DATA		
PUMP TYPE (Circle One): <input checked="" type="radio"/> Submersible, <input type="radio"/> Turbine, <input type="radio"/> Jet, <input type="radio"/> Flowing Well, Other (Describe) _____		
POWER TYPE (Circle One): <input checked="" type="radio"/> Electric, <input type="radio"/> Tractor, <input type="radio"/> Diesel, <input type="radio"/> Gasoline, <input type="radio"/> Butane, Other (Describe) _____		
Pump Capacity (GPM) <i>10</i>	No. of Stages <i>9</i>	Setting Depth <i>120</i> FT.
PUMP TEST		
Well yielded _____ GPM with a drawdown of _____ ft. after _____ hours of pumping		

WELL DATA		
Well Depth <i>160</i>	Casing Diameter (In.) <i>4</i>	Casing Length (Ft.) <i>150</i>
Type of Casing <i>PVC</i>	Hole Depth <i>160</i>	Depth to Static Water Level <i>90</i>
TYPE OF COMPLETION: (Circle One or More): <input checked="" type="radio"/> Gravel Packed, <input type="radio"/> Underreamed, <input type="radio"/> Telescoped, <input checked="" type="radio"/> Natural Development, <input type="radio"/> Open Hole, <input type="radio"/> Other (Describe) _____		
Top of Lap Pipe or Reduction in Casing FEET <input type="checkbox"/> IF TELESCOPED OR MORE THAN ONE SCREEN: USE BACK PAGE		


LOG DATA	
TYPE OF LOG RUN (Circle One): <input checked="" type="radio"/> No Log Run, <input type="radio"/> Electric, <input type="radio"/> Gamma Ray, <input type="radio"/> Density, <input type="radio"/> Sonic, <input type="radio"/> Neutron, Other (Describe) _____	
Name of Organization Running Log	

SCREEN DATA		
Diameter - Inches <i>4</i>	Length - Feet <i>10</i>	Slot Size - Inches <i>.013</i>
Screen Type <i>PVC</i>	Depth to Bottom - Feet <i>8</i>	

GEOLOGIC DATA (Office Use Only)			
Surface Elev.	Geologic Unit	Unit Thickness	Depth to Top
Subs. SWL	Date	Analysis	Aquifer Test

Driller's Remarks

DESCRIPTION OF FORMATIONS ENCOUNTERED	FROM	TO
<i>Red Clay</i>	<i>0</i>	<i>10</i>
<i>Red Sand</i>	<i>10</i>	<i>30</i>
<i>Gravel</i>	<i>30</i>	<i>95</i>
<i>white clay</i>	<i>95</i>	<i>110</i>
<i>white sand</i>	<i>118</i>	<i>160</i>

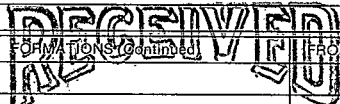


SEP 14 1988

Department of Natural Resources
Bureau of Land & Water Resources

IF MORE SPACE IS NEEDED, USE BACK

If well telescopes please
sketch and show depths.

GROUND LEVEL

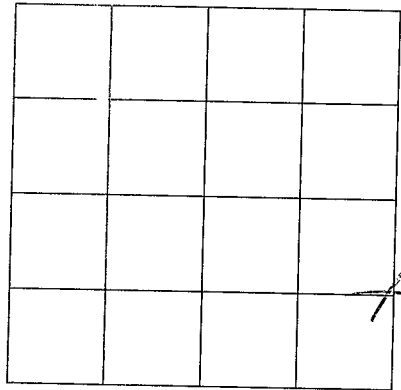

SECTION 30

Please indicate well location X.

ADDITIONAL INFORMATION