

MISSISSIPPI DEPARTMENT OF NATURAL RESOURCES

Bureau of Land and Water Resources

P.O. Box 10631

Jackson, Mississippi 39209

WATER WELL DRILLERS LOG

COUNTY WELL LOCATED <i>Paducah</i>	
WELL NUMBER <i>C 2029</i>	CODED
DATE WELL COMPLETED <i>8-10-89</i>	

PERMIT NUMBER <i>HICKS WELL COMPANY</i>
NAME OF DRILLING FIRM <i>RT. 1 - BOX 157</i>
<i>SENATOBIA, MISS.</i>

NAME & MAILING ADDRESS OF LANDOWNER <i>C/De Hidderson</i>			
<i>RT-1</i>			
<i>COMO, MS 38619</i>			
WELL LOCATION:	SEC	TOWNSHIP	RANGE
	<i>29</i>	<i>296^N</i>	<i>7^E</i>
DISTANCE	DIRECTION	NEAREST TOWN	
<i>2</i> Miles	<i>N</i>	of <i>COMO</i>	
OTHER LANDMARK			
WELL PURPOSE <input checked="" type="checkbox"/> Home Irrigation, Municipal, Industrial, Fish Pond, etc.			

PUMP DATA			
PUMP TYPE (Circle One): <input checked="" type="checkbox"/> Submersible, Turbine, Jet, Flowing Well, Other (Describe) _____			
POWER TYPE (Circle One): <input checked="" type="checkbox"/> Electric, Tractor, Diesel, Gasoline, Butane, Other (Describe) _____ H/P <i>1/2</i>			
Pump Capacity (GPM)	No. of Stages	Setting Depth	
<i>10</i>	<i>9</i>	<i>110</i> FT.	
PUMP TEST			
Well yielded <i>10</i> GPM with a drawdown of _____ ft. after _____ hours of pumping			

WELL DATA

Well Depth <i>140</i>	Casing Diameter (In.) <i>4"</i>	Casing Length (Ft.) <i>130</i>
Type of Casing <i>PVC</i>	Hole Depth <i>140</i>	Depth to Static Water Level <i>90</i>
TYPE OF COMPLETION: (Circle One or More): <input checked="" type="checkbox"/> Gravel Packed, <input type="checkbox"/> Underreamed, <input type="checkbox"/> Telescoped, <input type="checkbox"/> Natural Development, <input type="checkbox"/> Open Hole, <input type="checkbox"/> Other		
Top of Lap Pipe or Reduction in Casing		
FEET <input type="checkbox"/> IF TELESCOPED OR MORE THAN ONE SCREEN: USE BACK PAGE		

LOG DATA

TYPE OF LOG RUN (Circle One): <input type="checkbox"/> No Log Run, <input type="checkbox"/> Electric, Gamma Ray, Density, Sonic, Neutron, Other (Describe) _____	
Name of Organization Running Log	

GEOLOGIC DATA (Office Use Only)

Surface Elev.	Geologic Unit	Unit Thickness	Depth to Top
Subs. SWL	Date	Analysis	Aquifer Test
Driller's Remarks			

SCREEN DATA


Diameter - Inches <i>4"</i>	Length - Feet <i>10'</i>	Slot Size - Inches <i>013</i>
Screen Type <i>PVC</i>	Depth to Bottom - Feet <i>10</i>	

DESCRIPTION OF FORMATIONS ENCOUNTERED	FROM	TO	FORMATIONS (Continued)	FROM	TO
<i>RC</i>	<i>0</i>	<i>20</i>	RECEIVED <i>NOV 07 1989</i> Department of Natural Resources Bureau of Land & Water Resources		
<i>RC & S</i>	<i>20</i>	<i>60</i>			
<i>Grar - S</i>	<i>60</i>	<i>90</i>			
<i>WS & S</i>	<i>90</i>	<i>110</i>			
<i>WS</i>	<i>110</i>	<i>140</i>			

IF MORE SPACE IS NEEDED, USE BACK

If well telescopes please sketch and show depths.

GROUND LEVEL

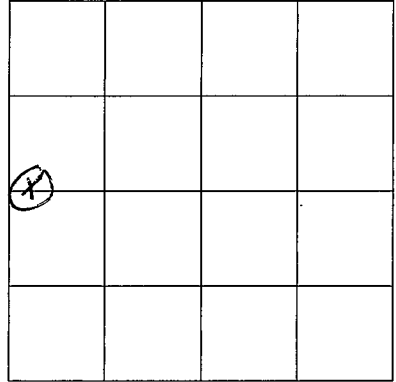

SECTION 29

Please indicate well location X.

ADDITIONAL INFORMATION

If more than one screen,
show location of each on sketch.