

MISSISSIPPI DEPARTMENT OF ENVIRONMENTAL QUALITY
Bureau of Land and Water Resources

P. O. Box 10631
Jackson, MS 39289-0631
WATER WELL DRILLERS LOG

| | |
|---|-------|
| COUNTY WELL LOCATED <i>SENATOBIA</i> | |
| WELL NUMBER <i>C 2033</i> | CODED |
| DATE WELL COMPLETED <i>6-2-93</i> | |

| |
|---|
| PERMIT NUMBER HICKS WELL CO. |
| NAME OF DRILLING FIRM RT. 1 BOX 157 SENATOBIA, MS 38668 |

| | | |
|---|------------|------------------|
| NAME & MAILING ADDRESS OF LANDOWNER <i>ollie Buford</i> | | |
| <i>Rt 1 Box 308</i> | | |
| <i>Senatobia ms</i> | | |
| WELL LOCATION: SEC | TOWNSHIP | RANGE |
| <i>13</i> | <i>6 N</i> | <i>7 E</i> |
| DISTANCE | DIRECTION | NEAREST TOWN |
| <i>5</i> Miles | <i>SE</i> | <i>Senatobia</i> |
| OTHER LANDMARK | | |
| WELL PURPOSE: Home, Irrigation, Municipal, Industrial, Fish Pond, etc. <i>Home</i> | | |

| | | |
|---|---------------|----------------------------|
| PUMP DATA | | |
| PUMP TYPE (Circle One): <input checked="" type="radio"/> Submersible, Turbine, Jet, Flowing Well, Other (Describe) _____ | | |
| POWER TYPE (Circle One): <input checked="" type="radio"/> Electric, Tractor, Diesel, Gasoline, Butane, Other (Describe) _____ H/P _____ | | |
| Pump Capacity (GPM) <i>10</i> | No. of Stages | Setting Depth _____ FT. |
| PUMP TEST | | |
| Well yielded _____ GPM with a drawdown of _____ ft. after _____ hours of pumping | | |

| | | |
|--|-----------------------------------|--|
| WELL DATA | | |
| Well Depth <i>100</i> | Casing Diameter (In.) <i>4</i> | Casing Length (Ft.) <i>90</i> |
| Type of Casing <i>Pvc</i> | Hole Depth <i>100</i> | Depth to Static Water Level <i>40</i> |
| TYPE OF COMPLETION: (Circle One or More): <input checked="" type="radio"/> Gravel Packed, Underreamed, Telescoped, Natural Development, Open Hole, Other (Describe) _____ | | |
| Top of Lap Pipe or Reduction in Casing _____ FEET IF TELESKOPED OR MORE THAN ONE SCREEN: USE BACK PAGE | | |

| | |
|--|--|
| LOG DATA | |
| TYPE OF LOG RUN (Circle One): No Log Run, Electric, Gamma Ray, Density, Sonic, Neutron, Other (Describe) _____ | |
| Name of Organization Running Log | |

| | | |
|-------------------------------|-------------------------------------|---------------------------------|
| SCREEN DATA | | |
| Diameter - Inches <i>4</i> | Length - Feet <i>10</i> | Slot Size - Inches <i>13</i> |
| Screen Type <i>Pvc</i> | Depth to Bottom - Feet <i>10</i> | |


| | | | |
|---------------------------------|---------------|----------------|--------------|
| GEOLOGIC DATA (Office Use Only) | | | |
| Surface Elev. | Geologic Unit | Unit Thickness | Depth to Top |
| Subs. SWL | Date | Analysis | Aquifer Test |
| Driller's Remarks | | | |

| DESCRIPTION OF FORMATIONS ENCOUNTERED | FROM | TO | FORMATION (continued) | FROM | TO |
|---------------------------------------|-----------|------------|-----------------------|--------------------|--|
| <i>Red SAND</i> | <i>0</i> | <i>20</i> | RECEIVED | AUG 23 1993 | Dept. of Environmental Quality Office of Land & Water Resources |
| <i>White SAND</i> | <i>20</i> | <i>100</i> | | | |
| | | | | | |
| | | | | | |
IF MORE SPACE IS NEEDED, USE BACK

If well telescopes please
sketch and show depths.

GROUND LEVEL

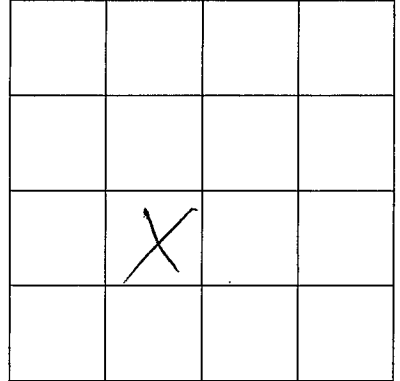

SECTION _____

Please indicate well location X.

ADDITIONAL INFORMATION

If more than one screen,
show location of each on sketch.