

MISSISSIPPI DEPARTMENT OF ENVIRONMENTAL QUALITY

Office of Land and Water Resources

P. O. Box 10631
Jackson, MS 39289-0631
WATER WELL DRILLERS LOG

COUNTY WELL LOCATED PANOLA	
WELL NUMBER C 2038	CODED
DATE WELL COMPLETED 10-23-96	

PERMIT NUMBER HICK WATER WELL CO.
NAME OF DRILLING FIRM 30242 HWY. 4 EAST
SENATOBIA, MS 38668

NAME & MAILING ADDRESS OF LANDOWNER Isiah WARD			
294 Abe Chapel Rd			
Como, MS 38619			
WELL LOCATION: SEC	TOWNSHIP	RANGE	
29	6 N	7 E	
DISTANCE 1 1/2 Miles	DIRECTION NW	NEAREST TOWN Como	
OTHER LANDMARK			
WELL PURPOSE: Home Irrigation, Municipal, Industrial, Fish Pond, etc.			

PUMP DATA		
PUMP TYPE (Circle One): Submersible Turbine, Jet, Flowing Well, Other (Describe)		
POWER TYPE (Circle One): Electric Tractor, Diesel, Gasoline, 1/2 Butane, Other (Describe) H/P 1/2		
Pump Capacity (GPM) 10	No. of Stages	Setting Depth 110 FT.
PUMP TEST		
Well yielded _____ GPM with a drawdown of no test ft. after _____ hours of pumping		

WELL DATA		
Well Depth 210	Casing Diameter (In.) 4	Casing Length (Ft.) 200
Type of Casing PVC	Hole Depth 210	Depth to Static Water Level 80
TYPE OF COMPLETION: (Circle One or More): Gravel Packed Underreamed, Telescoped, Natural Development, Open Hole, Other (Describe)		
WELL GROUTED TO A DEPTH OF 3 FEET Type Grout (circle one) Cement , Bentonite, or Mix		

LOG DATA	
TYPE OF LOG RUN (Circle One): No Log Run Electric, Gamma Ray, Density, Sonic, Neutron, Other (Describe)	
Name of Organization Running Log	

SCREEN DATA		
Diameter - Inches 4	Length - Feet 10	Slot Size - Inches .013
Screen Type PVC Slot	Depth to Bottom - Feet 200	

GEOLOGIC DATA (Office Use Only)			
Surface Elev.	Geologic Unit	Unit Thickness	Depth to Top
Subs. SWL	Date	Analysis	Aquifer Test
Driller's Remarks			
Top of Lap Pipe or Reduction in Casing			
FEET		IF TELESCOPED OR MORE THAN ONE SCREEN: USE BACK PAGE	


DESCRIPTION OF FORMATIONS ENCOUNTERED	FROM	TO	FORM. CONTINUED FROM	TO
Red Clay	0	20		
Red Sand	20	40		
Gravel	40	90		
Gravel + White Clay	90	120		
White Sand + Clay	120	180		
White Sand	180	210		

RECEIVED
APR 11 1997
Dept. of Environmental Quality
Office of Land & Water Resources

IF MORE SPACE IS NEEDED, USE BACK

If well telescopes please
sketch and show depths.

GROUND LEVEL

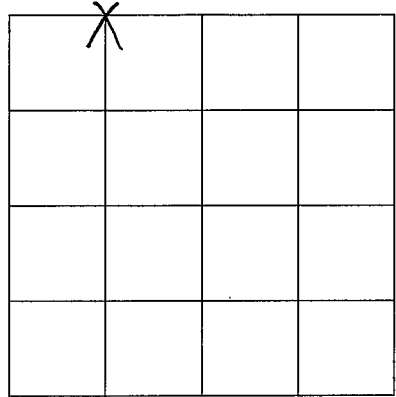

SECTION 29

Please indicate well location X.

ADDITIONAL INFORMATION

If more than one screen,
show location of each on sketch.