

MISSISSIPPI DEPARTMENT OF ENVIRONMENTAL QUALITY

Office of Land and Water Resources

P. O. Box 10631
Jackson, MS 39289-0631
WATER WELL DRILLERS LOG

COUNTY WELL LOCATED
Panola

WELL NUMBER CODED
C 2039

DATE WELL COMPLETED
11-24-96

PERMIT NUMBER

NAME OF DRILLING FIRM
HICK WATER WELL CO.

30242 HWY. 4 EAST
SENATOBIA, MS 38668

NAME & MAILING ADDRESS OF LANDOWNER
Fred Butts
Hunter Chapel Rd
Como, MS 38619

WELL LOCATION: SEC 25 TOWNSHIP 6 RANGE 7
N E
W

DISTANCE DIRECTION NEAREST TOWN
2 1/2 Miles E of Como

OTHER LANDMARK

WELL PURPOSE: Home Irrigation, Municipal, Industrial, Fish Pond, etc.

PUMP DATA

PUMP TYPE (Circle One):
Submersible Turbine, Jet, Flowing Well,
Other (Describe) _____

POWER TYPE (Circle One):
Electric Tractor, Diesel, Gasoline, Butane,
Other (Describe) _____ H/P _____

Pump Capacity (GPM) No. of Stages Setting Depth
10 100 FT.

PUMP TEST

Well yielded no GPM with
a drawdown of Test ft.
after _____ hours of pumping

WELL DATA

Well Depth Casing Diameter (In.) Casing Length (Ft.)
183 4 173

Type of Casing Hole Depth Depth to Static Water Level
PVC 183 70

TYPE OF COMPLETION: (Circle One or More):
Gravel Packed Underreamed, Telescoped,
Natural Development, Open Hole, Other
(Describe) _____

WELL GROUTED TO A DEPTH OF 3 FEET
Type Grout (circle one): Cement, Bentonite, or Mix

LOG DATA

TYPE OF LOG RUN (Circle One): No Log Run
Electric, Gamma Ray, Density, Sonic, Neutron,
Other (Describe) _____

Name of Organization Running Log

SCREEN DATA

Diameter - Inches Length - Feet Slot Size - Inches
4 10 .013

Screen Type Depth to Bottom - Feet
PVC Slot 173

GEOLOGIC DATA (Office Use Only)

| Surface Elev. | Geologic Unit | Unit Thickness | Depth to Top |
|---------------|---------------|----------------|--------------|
| Subs. SWL | Date | Analysis | Aquifer Test |

Driller's Remarks

Top of Lap Pipe or Reduction in Casing

FEET IF TELESCOPED OR MORE THAN ONE SCREEN: USE BACK PAGE

| DESCRIPTION OF FORMATIONS ENCOUNTERED | FROM | TO |
|---------------------------------------|------------|------------|
| <u>Red Clay</u> | <u>0</u> | <u>15</u> |
| <u>Red Sand</u> | <u>15</u> | <u>35</u> |
| <u>Gravel</u> | <u>35</u> | <u>90</u> |
| <u>Red Clay + Sand</u> | <u>90</u> | <u>140</u> |
| <u>White Sand</u> | <u>140</u> | <u>183</u> |
| | | |
| | | |

FORM NO. 10 (Rev. 11/83)

RECEIVED


APR 11 1997

Dept. of Environmental Quality
Office of Land & Water Resources

IF MORE SPACE IS NEEDED, USE BACK

If well telescopes please
sketch and show depths.

GROUND LEVEL

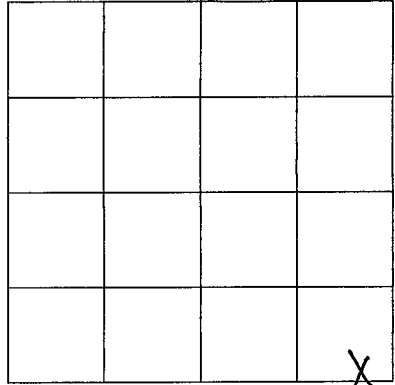

SECTION 25

Please indicate well location X.

ADDITIONAL INFORMATION

If more than one screen,
show location of each on sketch.