

MISSISSIPPI DEPARTMENT OF ENVIRONMENTAL QUALITY

Office of Land and Water Resources

COUNTY WELL LOCATED PANOLA	
WELL NUMBER C 20	CODED 40
DATE WELL COMPLETED 7-14-98	

HICKS WATER WELL CO.
30242 HWY. 4 EAST
SENATOBIA, MS 38668

P. O. Box 10631
Jackson, MS 39289-0631
WATER WELL DRILLERS LOG

NAME & MAILING ADDRESS OF LANDOWNER Kenneth Mormon		
15280 Old Panola Rd.		
Como, MS 38619		
WELL LOCATION: SEC	TOWNSHIP	RANGE
29	60	7
DISTANCE	DIRECTION	NEAREST TOWN
1 Miles	NW	Como
OTHER LANDMARK		
WELL PURPOSE: <input checked="" type="checkbox"/> Home Irrigation, Municipal, Industrial, Fish Pond, etc.		

PUMP DATA		
PUMP TYPE (Circle One): <input checked="" type="radio"/> Submersible Turbine, Jet Flowing Well, Other (Describe) _____		
POWER TYPE (Circle One): <input checked="" type="radio"/> Electric, Tractor, Diesel, Gasoline, 1/2 Butane, Other (Describe) _____ H/P 1/2		
Pump Capacity (GPM) 10	No. of Stages	Setting Depth 120 FT.
PUMP TEST		
Well yielded _____ GPM with a drawdown of no ft. after _____ hours of pumping		

WELL DATA		
Well Depth 180	Casing Diameter (In.) 4	Casing Length (Ft.) 170
Type of Casing PVC	Hole Depth 180	Depth to Static Water Level 90
TYPE OF COMPLETION: (Circle One or More): <input checked="" type="checkbox"/> Gravel Packed, Underreamed, Telescoped, Natural Development, Open Hole, Other (Describe) _____		
WELL GROUTED TO A DEPTH OF 3 FEET Type Grout (circle one) <input checked="" type="radio"/> Cement, Bentonite, or Mix		

LOG DATA	
TYPE OF LOG RUN (Circle One): Electric, Gamma Ray, Density, Sonic, <input checked="" type="radio"/> Neutron, Other (Describe) _____	
Name of Organization Running Log	

SCREEN DATA		
Diameter - Inches 4	Length - Feet 10	Slot Size - Inches .013
Screen Type PVC Slot.	Depth to Bottom - Feet 170	


GEOLOGIC DATA (Office Use Only)			
Surface Elev.	Geologic Unit	Unit Thickness	Depth to Top
Subs. SWL	Date	Analysis	Aquifer Test
Driller's Remarks			
Top of Lap Pipe or Reduction in Casing			
FEET			
IF TELESCOPED OR MORE THAN ONE SCREEN: USE BACK PAGE			

DESCRIPTION OF FORMATIONS ENCOUNTERED	FROM	TO	FORMATIONS (Continued)	FROM	TO
Red + White Clay	0	40			
Gravel + Clay mix	40	80			
Gravel + White Clay	80	140			
White Clay + Sand	140	170			
White Sand	170	180			

IF MORE SPACE IS NEEDED, USE BACK

If well telescopes please
sketch and show depths.

GROUND LEVEL

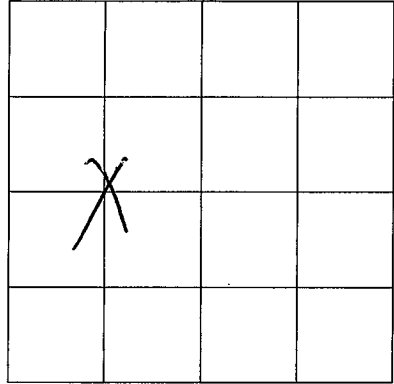

SECTION 29

Please indicate well location X.

ADDITIONAL INFORMATION

If more than one screen,
show location of each on sketch.