

D

10-1-62

WATER WELL-DRILLERS LOG

PANOLA

Date: _____, 19____, Driller: _____ County _____

(Name)

Robert Dean

(1) Owner of Land: Miss (Name)

(Address)

(2) Location: 1/4 East 1/4 Sec. C T R

12 miles East of Comer
(distance) (direction) (Nearest Town)

(3) Topography: FOR BAIT SHOT
(Hilly) (Flat) (Level)

(4) Purpose of Well: _____
(Domestic Irrigation
Municipal, Industrial, Other)

Description & Color of Materials:
Red Clay, Sand, etc.
white sand

Thick-
ness
feet

Depth
feet

90

110

Information upon completion of well:

(1) Diameter 1 1/2 inches.

(2) Total Depth 75 feet.

(3) Water level 110 feet below top of ground.

(4) Cased to 110 Size 2 1/2"

(5) Screen: Size 2, Length 5 FT

(6) Were any formations sealed against pollution?

_____ yes, _____ no.


If YES depth of formation _____

Why Did not have map

Drillers Remarks: 1/2 mile east of Comer

Miss along New Black

Top Road

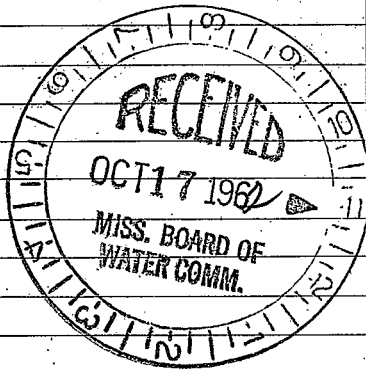

(Use Back Side)

Well No.

