

D

8-1-63

WATER WELL DRILLERS LOG

Date: 8-1, 1963, Driller: J B Cain County: Panola

(Name)

(1) Owner of Land: Hoge (Name) Sardis Miss (Address)

Description & Color of Materials Sand, Clay, Red Clay, Shell, etc.	Thick- ness Feet	Depth Feet
Clay	0	30
Sand	30	90

(2) Location: 1/4, 1/4, Sec. T R, 15 miles NE of Sardis (distance) (direction) (Nearest Town)

(3) Topography: (Hilly) (Flat) (Level)

(4) Purpose of Well: Home (Domestic Irrigation Municipal, Industrial, Other)

Information upon completion of well:

(1) Diameter 2 inches.

(2) Total Depth 90 feet.

(3) Water Level 70 feet below top of ground.

(4) Cased to 90, Size 2"


(5) Screen: Size 1 1/4, Length 5 FT

(6) Were any formations sealed against pollution? yes, no.

If YES depth of formation

Why

Drillers Remarks:

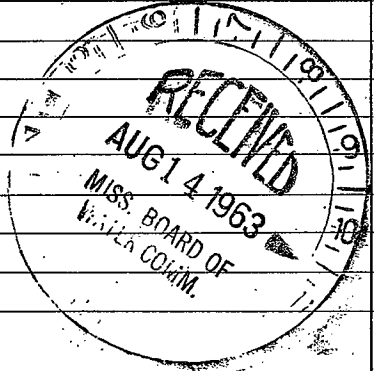

(Use Back Side)

Well No.

