

PA NOLA

MISSISSIPPI BOARD OF WATER COMMISSIONERS

D
8-15-63

WATER WELL DRILLERS LOG

Date: 8-15, 1963 Driller: JB CAIN County: Panola

(Name)

(1) Owner of Land: M. Rice
(Name)
Como mill
(Address)
RICE

Description & Color of Materials Sand, Clay, Red Clay, Shell, etc.	Thick- ness Feet	Depth Feet
<u>Clay</u>	<u>0</u>	<u>40</u>
<u>Sand</u>	<u>40</u>	<u>100</u>
<u>Clay</u>	<u>100</u>	<u>120</u>
<u>Soft</u>	<u>120</u>	<u>257</u>

(2) Location: 1/4, 1/4, Sec. T. R.
15 miles E of Como
(distance) (direction) (Nearest Town)

(3) Topography: (Hilly) (Flat) (Level)

(4) Purpose of Well:
(Domestic Irrigation
Municipal, Industrial, Other)

Information upon completion of well:

(1) Diameter 2 inches.

(2) Total Depth 257 feet.

(3) Water Level 160 feet below top of ground.

(4) Cased to 257, Size 2"


(5) Screen: Size 1/4, Length 6 FT
Strainer Lashed in

(6) Were any formations sealed against pollution?
 yes, no.

If YES depth of formation

Why

Drillers Remarks:

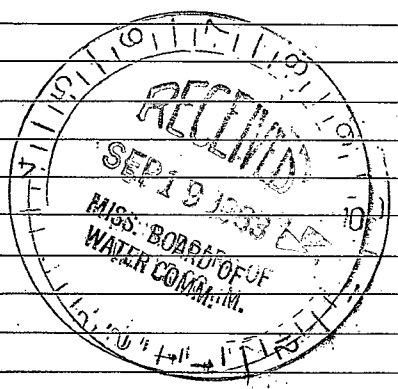

(Use Back Side)

Well No.

