

PANOLA

D

WATER WELL DRILLERS LOG

Date: 3-6, 1964, Driller: J B Cain

County: Panola

(Name)

(1) Owner of Land: Hag (Name)  
Lardis (Address)

Description & Color of Materials  
Sand, Clay, Red Clay, Shell, etc.

Thick-  
ness  
Feet

Depth  
Feet

Brd Cl  
Sand 0 5  
50 11

(2) Location: 1/4, 1/4, Sec. T R  
10 miles NE of SARDIS  
(distance) (direction) (Nearest Town)

(3) Topography: (Hilly) (Flat) (Level)

(4) Purpose of Well: Cation  
(Domestic Irrigation  
Municipal, Industrial, Other)

Information upon completion of well:

(1) Diameter 2 inches.

(2) Total Depth 110 feet.

(3) Water Level 70 feet below top of ground.

(4) Cased to 110, Size 2"


(5) Screen: Size 1 1/4, Length 5 FT

(6) Were any formations sealed against pollution?  
yes, no.

If YES depth of formation

Why

Drillers Remarks: I was looking  
two logs just drilled  
But two different  
wells

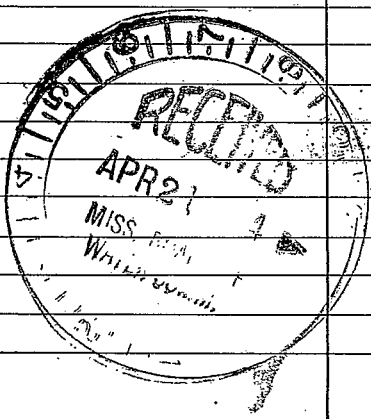

(Use Back Side)

Well No.

...the ...

...the ...

