

WATER WELL DRILLERS LOG

D
7-1-64

Date: 7-1, 1964, Driller: J B Cain County Panola
(Name)


(1) Owner of Land: <u>Pex Rusby</u> (Name) <u>2300 Comd Minn</u> (Address)	Description & Color of Materials Sand, Clay, Red Clay, Shell, etc. <u>Clay</u> <u>Sand</u>	Thick-ness Feet <u>0</u> <u>30</u>	Depth Feet <u>30</u> <u>200</u>
(2) Location: <u>1/4</u> , <u>1/4</u> , Sec. <u>T</u> <u>R</u> <u>12</u> miles <u>E</u> of <u>Comd</u> (distance) (direction) (Nearest Town)			
(3) Topography: <input checked="" type="checkbox"/> (Hilly) <input type="checkbox"/> (Flat) <input type="checkbox"/> (Level)			
(4) Purpose of Well: _____ (Domestic Irrigation Municipal, Industrial, Other)			

Information upon completion of well:

- (1) Diameter 2 inches.
- (2) Total Depth 200 feet.
- (3) Water Level 145 feet below top of ground.
- (4) Cased to 200, Size 2"
- (5) Screen: Size 1/4, Length 5 FT
- (6) Were any formations sealed against pollution?
_____ yes, _____ no.

If YES depth of formation _____
Why _____

Drillers Remarks: _____

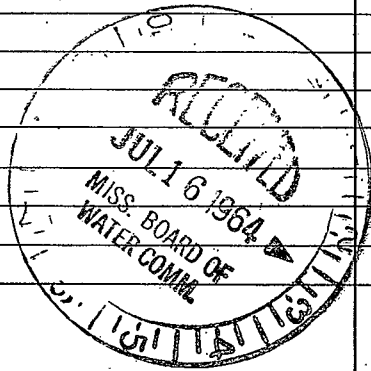

(Use Back Side)

Well No. _____

