

CODED

CODED

MISSISSIPPI
 BOARD OF WATER COMMISSIONERS
 416 North State Street
 Jackson, Mississippi 39201

CODED

CODED

WATER WELL DRILLERS LOG

Panola
DI
4-10-68

4-10 date well completed 168 Harris Bros firm name Panola county well located

LANDOWNER: <u>James Stockton</u>	description of formations encountered	from	to
<u>Rte 1</u> <u>Como, Miss.</u> (mailing address)	<u>top soil</u> <u>red sand</u> <u>clay and sand</u> <u>grey clay</u> <u>fine silt</u> <u>coarse sand</u>	<u>0</u> <u>29</u> <u>50</u> <u>120</u> <u>200</u> <u>220</u>	<u>25</u> <u>50</u> <u>120</u> <u>200</u> <u>220</u> <u>240</u>
WELL LOCATION: sec <u>33</u> T- <u>6</u> N R- <u>6</u> E <u>3 1/2</u> miles <u>East</u> of <u>Como</u> (distance) (direction) (nearest town)			
WELL PURPOSE: <u>home</u> (home, irrigation/municipal, industrial)			
WELL COMPLETION DATA: (1) diameter (inches) <u>4"</u> (2) total depth (feet) <u>240</u> (3) static water level (feet) <u>140</u> <u>(below)</u> top of ground. (4) casing <u>Plastic</u> , <u>126'</u> (material) (depth) <u>4</u> if telescope see back. (size) (5) screen <u>14'</u> , <u>126'</u> (length) (depth to top) <u>008</u> , <u>Plastic</u> (size) (material) (6) pump <u>3/4</u> <u>10</u> (HP) (yield gpm) <u>elec.</u> (type power) (7) electric log <u>no</u> (yes or no) <u>(organization running log)</u> (8) how well bottom plugged <u>back</u> <u>stop</u>			
DRILLERS REMARKS:			


CODED

JAN 21 1969

MISS. BD. OF WATER COM.

If well telescopes please sketch and show depths.

GROUND LEVEL

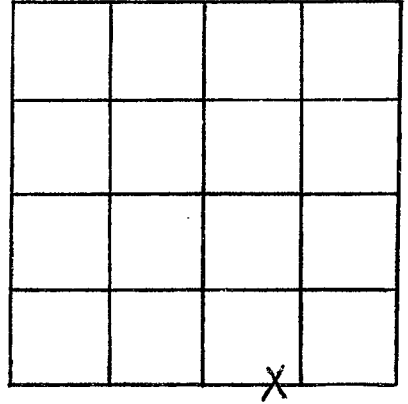

SECTION 33

Please indicate well location X.

ADDITIONAL INFORMATION

If more than one screen,
show locations of each on sketch.