

Panola  
D2  
4-8-69

MISSISSIPPI  
BOARD OF WATER COMMISSIONERS  
416 North State Street  
Jackson, Mississippi 39201

CODED

WATER WELL DRILLERS LOG

APRIL 8 - 1969 date well completed      White Bros. firm name      PANOLA county well located

LANDOWNER: <u>GEORGE WALDRIP</u> <u>Panola, Miss.</u> <u>Rt. 1</u> (mailing address)	description of formations encountered	from	to
	<u>TOP SOIL</u>	<u>0</u>	<u>15</u>
	<u>COARSE WHITE SAND</u>	<u>15</u>	<u>150</u>
	<u>EXTRA COARSE <del>COARSE</del> RED SAND</u>	<u>150</u>	<u>158</u>
	<u>MED. FINE WHITE SAND</u>	<u>158</u>	<u>174</u>
<b>WELL LOCATION:</b>			
sec. <u>21</u> T. <u>6</u> N. R. <u>5</u> E. <u>(S)</u> <u>(W)</u>			
<u>13</u> miles <u>EAST</u> of <u>Panola</u> (distance) (direction) (nearest town)			
<b>WELL PURPOSE:</b> <u>HOME</u> (home, irrigation, municipal, industrial)			
<b>WELL COMPLETION DATA:</b>			
(1) diameter (inches) <u>2"</u>			
(2) total depth (feet) <u>174 FT.</u>			
(3) static water level (feet) <u>110</u> <u>(below)</u> above top of ground.			
(4) casing <u>STEEL</u> , <u>168 FT.</u> (material) (depth)			
<u>2"</u> if telescope see back. (size)			
(5) screen <u>4 FT.</u> , <u>174 FT.</u> (length) (depth to top)			
<u>1 1/8"</u> , <u>STAINLESS STEEL</u> (size) (material)			
(6) pump <u>3/4</u> , <u>3</u> (HP) (yield gpm)			
<u>ELE.</u> (type power)			
(7) electric log <u>NO.</u> (yes or no)			
(organization running log)			
(8) how well bottom plugged <u>STRAINER</u>			
<b>DRILLERS REMARKS:</b>			


CODED

APR 12 1969

MISSISSIPPI  
BOARD OF WATER COMMISSIONERS

If well telescopes please sketch and show depths.

GROUND LEVEL

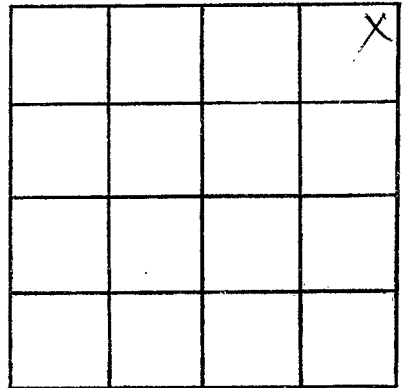

SECTION 21

Please indicate well location X.

ADDITIONAL INFORMATION

If more than one screen,  
show locations of each on sketch.