

Panola
D3
5-18-69

MISSISSIPPI
BOARD OF WATER COMMISSIONERS
416 North State Street
Jackson, Mississippi 39201

CODED

WATER WELL DRILLERS LOG

May 18 1969 J. LEON WHITE Panola
date well completed firm name county well located

LANDOWNER: M.L. CRUISE
POMO RT. 1

description of formations encountered	from	to
TOP SOIL	0	12
MIXED SAND	12	124

(mailing address)

WELL LOCATION:
sec. 21 T. 6 N R. 5 E
16 miles EAST of POMO
(distance) (direction) (nearest town)

WELL PURPOSE: HOME
(home, irrigation, municipal, industrial)

WELL COMPLETION DATA:

- (1) diameter (inches) 2"
- (2) total depth (feet) 124'
- (3) static water level (feet) 115' below top of ground.
- (4) casing STEEL, 168' (material) (depth)
2 (size) If telescope see back.
- (5) screen 4' (length), 124' (depth to top)
1/4" (size), STAINLESS STEEL (material)
- (6) pump 3/4 Rod type 3 B.P.M. (HP) (yield gpm)
E.L.E. (type power)
- (7) electric log NO (yes or no)

(organization running log)

(8) how well bottom plugged STRAINERS


MAY 11 1969

DRILLERS REMARKS:

MISS. BD. OF
WATER COM.

If well telescopes please sketch and show depths.

GROUND LEVEL

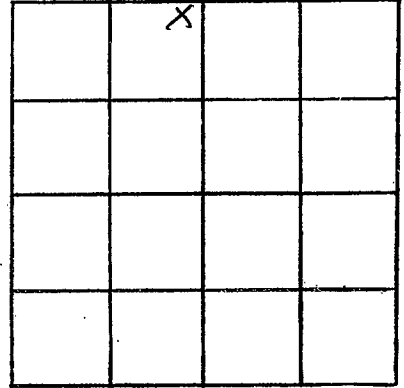

SECTION 21

Please indicate well location X.

ADDITIONAL INFORMATION

If more than one screen,
show locations of each on sketch.