

MISSISSIPPI
 BOARD OF WATER COMMISSIONERS
 416 North State Street
 Jackson, Mississippi 39201

CODED

WATER WELL DRILLERS LOG

PANOLA
 DL
 3-16-77

3-16-77 19 Jim Renix Panola
 date well completed firm name county well located

LANDOWNER: Lucius Pratcher

description of formations encountered

from to

Rt. 1

Dirt	0	10
Sand & Clay Mix	10	120
Clay	120	150
Sand	150	175

Como, Miss.
 (mailing address)

WELL LOCATION:

sec. 25 T. 6 N R. 6 W.
 S W.
 18 miles East of Como
 (distance) (direction) (nearest town)

WELL PURPOSE: Home
 (home, irrigation, municipal, industrial)

WELL COMPLETION DATA:

- (1) diameter (inches) 2 & # 1 1/2
- (2) total depth (feet) 175
- (3) static water level (feet) 75 below top of ground.
- (4) casing Galv. 171
 (material) (depth)
 2 & 1 1/2 if telescope see back.
 (size)
- (5) screen 4 Ft. 171
 (length) (depth to top)
 1 1/4 in. Stainless Steel
 (size) (material)
- (6) pump 1/2 4
 (HP) (yield gpm)
 Elec.
 (type power)
- (7) electric log No
 (yes or no)
 (organization running log)
- (8) how well bottom plugged Open



CODED

APR - 5 1977

DRILLERS REMARKS:

MISS. BD. OF
 WATER COMM.

If well telescopes please sketch and show depths.

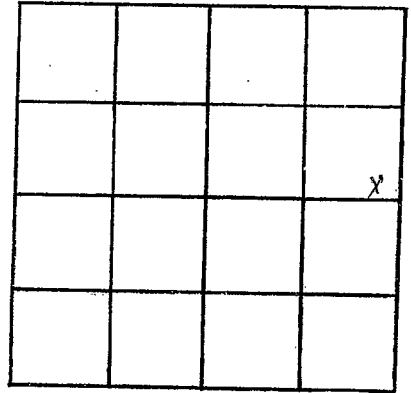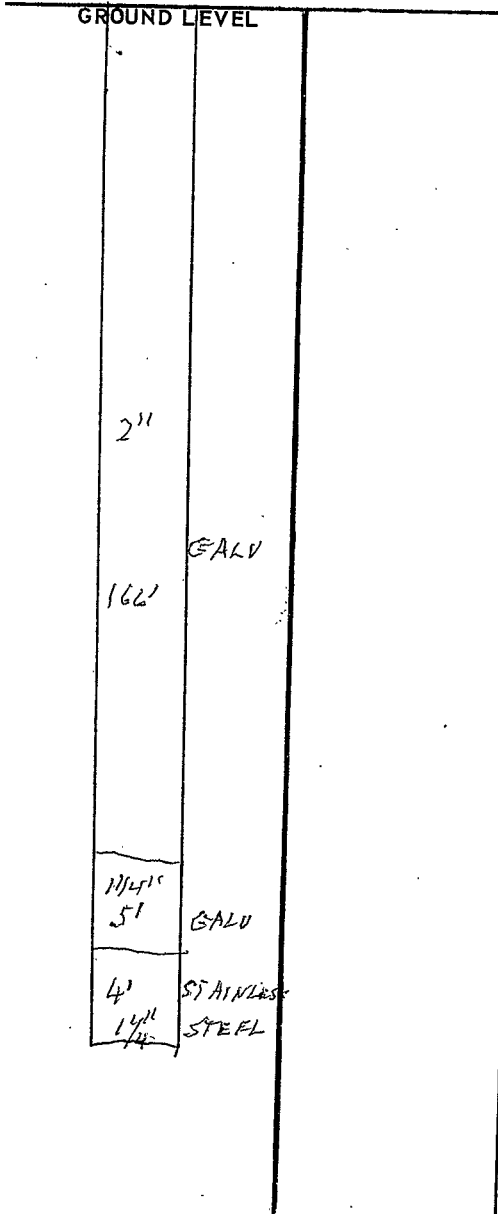

SECTION 25

Please indicate well location X.

ADDITIONAL INFORMATION

If more than one screen, show locations of each on sketch.