

PANOLA

D 7

4-20-71

MISSISSIPPI
 BOARD OF WATER COMMISSIONERS
 416 North State Street
 Jackson, Mississippi 39201

CODED

WATER WELL DRILLERS LOG

APRIL 20, 1971
date well completed

JILEON WHITE
firm name

PANOLA
county well located

LANDOWNER: Columbus Jackson

Corno, Miss -
Rt. 1
(mailing address)

description of formations encountered

from to

TOP SOIL	0	12
COARSE WHITE SAND	12	46
YELLOW CLAY	46	90
MED COARSE WHITE SAND	90	138
MED FINE SAND	138	160
MED COARSE SAND	160	185
COARSE WHITE SAND	185	212

WELL LOCATION:

sec 29 T 6 N R 5 E
(S) (W)
12 miles EAST of Corno
(distance) (direction) (nearest town)

WELL PURPOSE: HOME
(home, irrigation, municipal, industrial)

WELL COMPLETION DATA:

- (1) diameter (inches) 4"
- (2) total depth (feet) 212 FT.
- (3) static water level (feet) 140 ^{below}/_{above} top of ground.
- (4) casing PLASTIC, 206 FT.
(material) (depth)
4" if telescope see back.
(size)
- (5) screen 6, 212 FT.
(length) (depth to top)
2", STAINLESS STEEL
(size) (material)
- (6) pump 1/2, 5
(HP) (yield gpm)
- ELE.
(type power)
- (7) electric log NO
(yes or no)

CODED

MAY 6 = 1971

(organization running log)


(8) how well bottom plugged STRAINER

MISS. Bd. OF
WATER COMMISSIONERS

DRILLERS REMARKS:

If well telescopes please sketch and show depths.

GROUND LEVEL

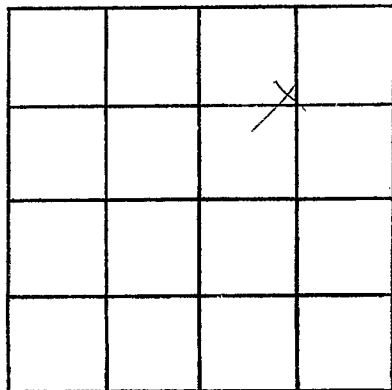

SECTION 29

Please indicate well location X.

ADDITIONAL INFORMATION

If more than one screen,
show locations of each on sketch.