

WATER WELL DRILLERS LOG

CODED

ANOLA
D8
1-22-64

Date: 1-22, 1964, Driller: Abco of Independence County Panola
(Name)

(1) Owner of Land: J. H. Bramlett

(Name)

Coma, Rte
(Address) 2965

(2) Location: 1/4, 1/4, Sec. T R R

_____ miles _____ of _____
(distance) (direction) (Nearest Town)

(3) Topography: _____
(Hilly) (Flat) (Level)

(4) Purpose of Well: _____
(Domestic Irrigation
Municipal, Industrial, Other)

Information upon completion of well:

(1) Diameter 4 inches.

(2) Total Depth 180 feet.

(3) Water Level _____ feet below top of ground.

(4) Cased to 173, Size _____

(5) Screen: Size 4", Length 7'

(6) Were any formations sealed against pollution?

_____ yes, _____ no.

If YES depth of formation _____

Why _____

Drillers Remarks: _____


Description & Color of Materials
Sand, Clay, Red Clay, Shell, etc.

Thick-
ness
Feet

Depth
Feet

top soil	0	15
red sand	15	40
yellow sand & clay	40	120
white sand & clay	120	140
white cement sand	140	160
coarse white sand	160	180

CODED

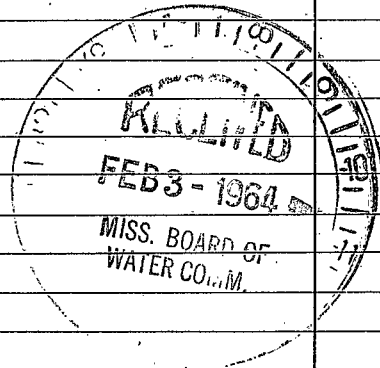

(Use Back Side)

Well No.

