

PANOLA

MISSISSIPPI BOARD OF WATER COMMISSIONERS
416 North State Street
Jackson, Mississippi 39201

WATER WELL DRILLERS LOG

CODED PANOLA

~~XXXXXXXXXX~~
D 10
12-6-71

12/6/1971 date well completed G. and H. Well Co. firm name Mississippi State county well located


LANDOWNER:	description of formations encountered	from	to
Dad Langtom	Red Clay	1	15
Route 1, Como, Mississippi	" "	15	25
(mailing address)	" "	25	35
	" "	35	45
WELL LOCATION:	White Clay	45	55
sec. 30 T 6 N R 5 E	" "	55	65
8 miles NE of Como	" "	65	75
(distance) (direction) (nearest town)	Sandy Clay	75	85
WELL PURPOSE: Home	" "	85	95
(home, irrigation, municipal, industrial)	" "	95	105
WELL COMPLETION DATA:	" "	105	115
(1) diameter (inches) x 4 Inches	" "	115	125
(2) total depth (feet) 220	" "	125	135
(3) static water level (feet) 160 below top of ground.	" "	135	145
(4) casing Plastic 220 (material) (depth)	" "	145	155
(size) If telescope see back.	" "	155	165
(5) screen 5 ft. 6 ft. 2 in (length) (depth to top)	White Sand	165	175
4 in. Gravel (size) (material)	" "	175	185
(3/4) (5GPM)	" "	185	195
(6) pump Electric (HP) (yield gpm)	" "	195	205
(type power) No	" "	205	215
(7) electric log (yes or no)	" "	215	220
(organization running log)			
(8) how well bottom plugged Cap			
DRILLERS REMARKS:			

CODED

JAN 13 1972

MISS. BD. OF WATER COMMISSIONERS

If well telescopes please sketch and show depths.

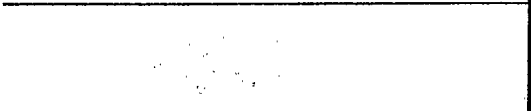

GROUND LEVEL

SECTION _____

Please indicate well location X.

ADDITIONAL INFORMATION

If more than one screen, show locations of each on sketch.