

PANOLA
D 11
3-16-72

MISSISSIPPI
 BOARD OF WATER COMMISSIONERS
 416 North State Street
 Jackson, Mississippi 39201

WATER WELL DRILLERS LOG

CODED

MARCH 16 1972 J. LEON WHITE PANOLA
 date well completed firm name county/well located

LANDOWNER: Bemis Brunt
Como, Miss.
Rt. 1
 (mailing address)

description of formations encountered	from	to
TOP SOIL	0	22
MEDIUM BROWN SAND	22	70
FINE WHITE SAND	70-122	
COARSE WHITE SAND	122	210

WELL LOCATION:
 sec 21 T 6 N R 5 E
12 miles EAST of Como
 (distance) (direction) (nearest town)

WELL PURPOSE: HOME
 (home, irrigation, municipal, industrial)

- WELL COMPLETION DATA:
- (1) diameter (inches) 4"
 - (2) total depth (feet) 210
 - (3) static water level (feet) 155 ^(below) above top of ground.
 - (4) casing PLASTIC, 200,
 (material) (depth)
4" if telescope see back.
 (size)
 - (5) screen 10', 210'
 (length) (depth to top)
2, SAND PACK PLASTIC
 (size) (material)
 - (6) pump 3/4 10
 (HP) (yield gpm)
ELE.
 (type power)
 - (7) electric log NO.
 (yes or no)
 - (organization running log)
 - (8) how well bottom plugged WASH BOTTOM

CODED


APR 6 1972

DRILLERS REMARKS:

MISS. DEPT. OF
 WATER RESOURCES

If well telescopes please sketch and show depths.

GROUND LEVEL

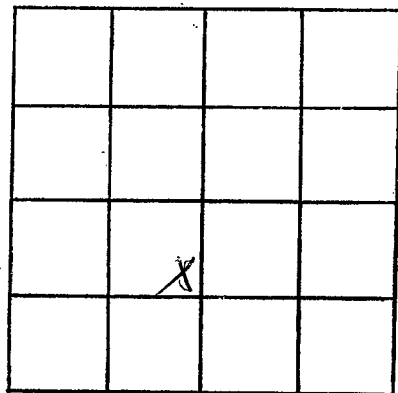

SECTION 21

Please indicate well location X.

ADDITIONAL INFORMATION

If more than one screen,
show locations of each on sketch.