

PANOLA
D12
10-4-72

MISSISSIPPI
 BOARD OF WATER COMMISSIONERS
 416 North State Street
 Jackson, Mississippi 39201

CODED

WATER WELL DRILLERS LOG

10-4- 1972 Hicks Brothers PANOLA
 date well completed firm name county well located

LANDOWNER: Ray Ladd
23 Sene
Memphis Tenn
 (mailing address)

description of formations encountered	from	to
<u>Red Clay</u>	<u>0</u>	<u>15</u>
<u>Red sand</u>	<u>15</u>	<u>90</u>
<u>White Clay</u>	<u>90</u>	<u>150</u>
<u>White sand</u>	<u>150</u>	<u>215</u>

WELL LOCATION:
 sec 36 T 6 N R 6 E
10 miles East of COMO
 (distance) (direction) (nearest town)

WELL PURPOSE: HOME
 (home, irrigation, municipal, industrial)

- WELL COMPLETION DATA:
- (1) diameter (inches) 4"
 - (2) total depth (feet) 215
 - (3) static water level (feet) 120 below above top of ground.
 - (4) casing Plastic, 209
 (material) (depth)
 _____ if telescope see back.
 (size)
 - (5) screen 6', 6'
 (length) (depth to top)
4", Gravel Plastic
 (size) (material)
 - (6) pump 3/4, 10-
 (HP) (yield gpm)
220 Elec
 (type power)
 - (7) electric log _____
 (yes or no)

 (organization running log)
 - (8) how well bottom plugged CAP.

CODED


OCT 18 1972

DRILLERS REMARKS:

MISS. BD. OF
 WATER COMMISSIONERS

If well telescopes please sketch and show depths.

GROUND LEVEL

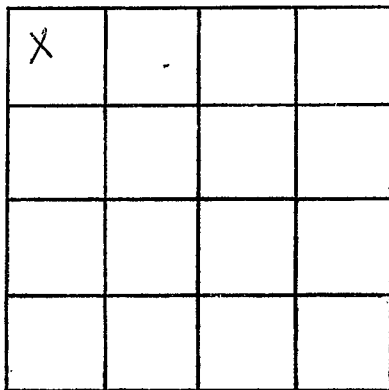

SECTION _____

Please indicate well location X.

ADDITIONAL INFORMATION

If more than one screen,
show locations of each on sketch.