

PANOLA
 D 15
 4-12-73

MISSISSIPPI
 BOARD OF WATER COMMISSIONERS
 416 North State Street
 Jackson, Mississippi 39201

CODED

WATER WELL DRILLERS LOG

4-12 date well completed 1973 James A. Lipe firm name Panola county well located

LANDOWNER:	description of formations encountered	from	to
Evander Smith Como Miss, (mailing address)			
	Clay	20	40
	"	40	60
	Sand	60	80
	Gravel	80	100
	"	100	120
	Clay	120	140
	"	140	160
	Sand	160	180
	"	180	198

WELL LOCATION:
 sec. 24 T. 6 N. R. 6 E.
 (S) (W)
6 miles west of Como
 (distance) (direction) (nearest town)

WELL PURPOSE: Home
 (home, irrigation, municipal, industrial)

WELL COMPLETION DATA:

- (1) diameter (inches) 4"
- (2) total depth (feet) 198'
- (3) static water level (feet) 110 below above top of ground.
- (4) casing PVC, 188,
 (material) (depth)
4"
 (size) if telescope see back.
- (5) screen 10, 188
 (length) (depth to top)
4, PVC
 (size) (material)
- (6) pump 3, 30
 (HP) (yield gpm)
Elec.
 (type power)
- (7) electric log no
 (yes or no)
no
 (organization running log)
- (8) how well bottom plugged PVC
plug


CODED

DRILLERS REMARKS:

APR 12 1973

If well telescopes please sketch and show depths.

GROUND LEVEL

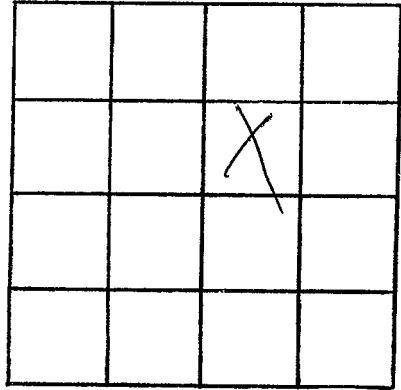

SECTION

21

Please indicate well location X.

ADDITIONAL INFORMATION

A series of horizontal lines for writing additional information.

If more than one screen, show locations of each on sketch.