

PANOLA
D 16
4-12-73

MISSISSIPPI
BOARD OF WATER COMMISSIONERS
416 North State Street
Jackson, Mississippi 39201

CODED

WATER WELL DRILLERS LOG


4-12-73 date well completed
James R. Lips Panola firm name
Panola county well located

LANDOWNER:	description of formations encountered	from	to
Henry Strickland Como Miss. (mailing address)	TOP SOIL	8	20
	CLAY	20	40
	SAND	40	60
	GRAVEL	60	80
	CLAY	80	100
	CLAY BLUE	100	120
	SAND AND CLAY	120	140
	SAND	140	180
WELL LOCATION: sec. 21 T 6 N R 6 E 6 miles west of Como (distance) (direction) (nearest town)			
WELL PURPOSE: HOME (home, irrigation, municipal, industrial)			
WELL COMPLETION DATA:			
(1) diameter (inches) 4"			
(2) total depth (feet) 180			
(3) static water level (feet) 120 below above top of ground.			
(4) casing PVC 170 (material) (depth)			
4 if telescope see back. (size)			
(5) screen 10 170 (length) (depth to top)			
4 PVC (size) (material)			
(6) pump 3/4 10 (HP) (yield gpm)			
E100 (type power)			
(7) electric log NO (yes or no)			
NO (organization running log)			
(8) how well bottom plugged PVC P100			
DRILLERS REMARKS:			

CODED

If well telescopes please sketch and show depths.

GROUND LEVEL

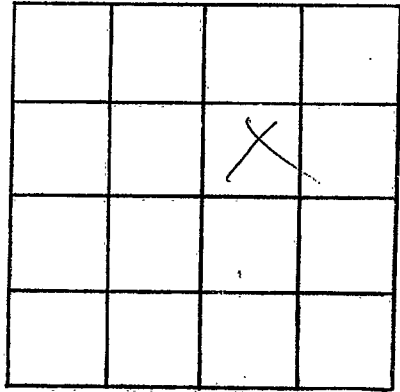

SECTION 21

Please indicate well location X.

ADDITIONAL INFORMATION

A series of horizontal lines for writing additional information.

If more than one screen, show locations of each on sketch.