

PANOLA
D17
4-16-73

MISSISSIPPI
BOARD OF WATER COMMISSIONERS
416 North State Street
Jackson, Mississippi 39201

CODED

WATER WELL DRILLERS LOG


4-16 date well completed 19 23 James R. Lipe firm name Panola county well located

LANDOWNER:	description of formations encountered	from	to
E. W. Atkinson	Top Soil	0	20
COMO MISS. (mailing address)	CLAY	20	40
	sand	40	60
	gravel	60	80
	ll	80	100
	ll	100	120
WELL LOCATION:	sand	120	140
sec. 31 T. 6 N. R. 6 E	sand	140	200
3 miles East of COMO (distance) (direction) of (nearest town)			
WELL PURPOSE: Home (home, irrigation, municipal, industrial)			
WELL COMPLETION DATA:			
(1) diameter (inches) 4" if telescope see back.			
(2) total depth (feet) 200			
(3) static water level (feet) 60 below top of ground.			
(4) casing PVC 188 (material) (depth)			
(5) screen 4 (size) 12 (length) 188 (depth to top)			
(6) pump 4 (size) PVC (material) 5 (HP) 55 (yield gpm)			
(7) electric log Elec. (type power)			
(8) how well bottom plugged NO (yes or no) NO (organization running log)			
DRILLERS REMARKS:			

CODED

If well telescopes please sketch and show depths.

GROUND LEVEL

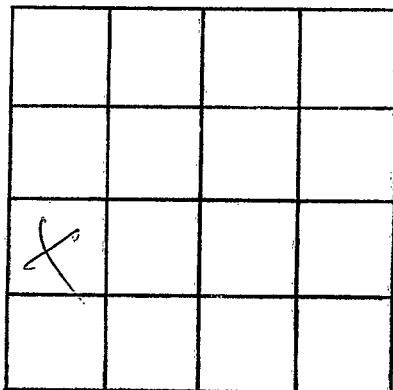

SECTION 31

Please indicate well location X.

ADDITIONAL INFORMATION

Lined area for additional information.

If more than one screen, show locations of each on sketch.