

PANOLA  
D 19  
5-11-73

MISSISSIPPI  
BOARD OF WATER COMMISSIONERS  
416 North State Street  
Jackson, Mississippi 39201

CODED

WATER WELL DRILLERS LOG

PANOLA

5 11 19  
date well completed

73 Robert Reed  
firm name KENIX

county well located

LANDOWNER: 8 miles East  
Como RT. 1 Robert Reed  
Panola  
(mailing address)

description of formations encountered	from	to
Shut	0	20
Clay sand	20	100
Clay streaked sand	100	130
Sand	130	177

WELL LOCATION:  
sec. 36 T. 6 N. R. 5 E  
8 miles East of Como  
(distance) (direction) (nearest town)

WELL PURPOSE:  
(home, irrigation, municipal, industrial)

WELL COMPLETION DATA: 5 11 73

CODED

- (1) diameter (inches) 2 1/4
- (2) total depth (feet) 158
- (3) static water level (feet) 158 below top of ground
- (4) casing (material) gal (depth) 2
- (5) screen (length) 43 (depth to top) 177
- (6) pump (HP) 1/3 (yield gpm) 250
- (7) electric log (yes or no) no
- (8) how well bottom plugged BWT


SEP 24 1973

MISSISSIPPI  
BOARD OF WATER COMMISSIONERS

DRILLERS REMARKS:

If well telescopes please sketch and show depths.

GROUND LEVEL

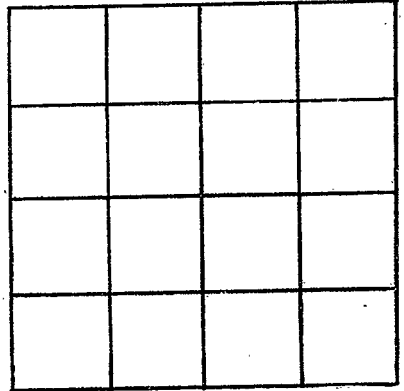

SECTION \_\_\_\_\_

Please indicate well location X.

ADDITIONAL INFORMATION

If more than one screen, show locations of each on sketch.